

MISSISSIPPI
 BOARD OF WATER COMMISSIONERS
 416 North State Street
 Jackson, Mississippi 39201

WATER WELL DRILLERS LOG

Aug 24 1972 Cherles Keene Pike
 date well completed firm name county well located

LANDOWNER: Don Manager
RFD Summit

description of formations encountered	from	to
<u>Red clay</u>	<u>0</u>	<u>20</u>
<u>Red Sand</u>	<u>20</u>	<u>40</u>
<u>gravel Sand</u>	<u>40</u>	<u>42</u>

(mailing address)

WELL LOCATION:
 sec. 17 T 4 N R. 7 E
3 miles W of Summit
 (distance) (direction) (nearest town)

WELL PURPOSE: House
 (home, irrigation, municipal, industrial)

WELL COMPLETION DATA:

- (1) diameter (inches) 4"
- (2) total depth (feet) 42
- (3) static water level (feet) 52 below above top of ground.
- (4) casing Plastic Ballast
 (material) (depth)
 (size) if telescope see back.
- (5) screen 6' 36'
 (length) (depth to top)
4" Plastic
 (size) (material)
- (6) pump 1/2 HP 12
 (HP) (yield gpm)
elect.
 (type power)
- (7) electric log NO
 (yes or no)

(organization running log)


(8) how well bottom plugged wooden plug

DRILLERS REMARKS:
new house

DEC 1 1972

If well telescopes please sketch and show depths.

GROUND LEVEL

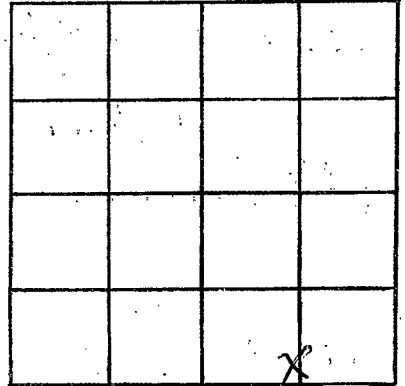

SECTION 17

Please indicate well location X.

ADDITIONAL INFORMATION

If more than one screen,
show locations of each on sketch.