

MISSISSIPPI
BOARD OF WATER COMMISSIONERS
416 North State Street
Jackson, Mississippi 39201



WATER WELL DRILLERS LOG

Pike
A141
10-16-72

Oct 16 1972 date well completed
chester reeves firm name
Pike county well located

LANDOWNER: James Henderson
RFD Summit (mailing address)

WELL LOCATION:
sec. 3 T. 4 N R. 7 E
3/2 miles WNW of Summit
(distance) (direction) (nearest town)

WELL PURPOSE: Home
(home, irrigation, municipal, industrial)

- WELL COMPLETION DATA:
- (1) diameter (inches) 10"
 - (2) total depth (feet) 114
 - (3) static water level (feet) 05 below top of ground
 - (4) casing Plast Ballman (material) (depth)
 - _____ If telescope see back. (size)
 - (5) screen 10' (length) 104' (depth to top)
10" (size) Plast (material)
 - (6) pump 1/2 sub (HP) 14 (yield gpm)
Elect (type power)
 - (7) electric log no (yes or no)
 - _____ (organization running log)
 - (8) how well bottom plugged wooden plug

| description of formations encountered | from | to |
|---------------------------------------|------|-----|
| clay | 0 | 14 |
| Red Sand & gravel | 14 | 76 |
| Small gravel | 76 | 92 |
| Sand & gravel | 92 | 101 |
| Red chalk | 101 | 114 |
| Small gravel & sand | | |




DEC 4 1972

DRILLERS REMARKS:
well well plugged

If well telescopes please sketch and show depths.

GROUND LEVEL

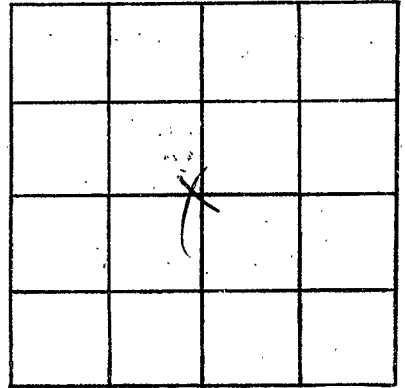

SECTION 3

Please indicate well location X.

ADDITIONAL INFORMATION

If more than one screen,
show locations of each on sketch.