

Pike  
A 142  
9-23-72

MISSISSIPPI  
BOARD OF WATER COMMISSIONERS  
416 North State Street  
Jackson, Mississippi 39201

**CODED**

WATER WELL DRILLERS LOG

Sept 23 1972 Chester Keener Pike  
date well completed firm name county well located

LANDOWNER: James C. Roberts  
Summit  
(mailing address)

description of formations encountered	from	to
	Red clay	0
Red sand	17	76
gravel & sand	76	92

WELL LOCATION:  
sec. 3 T. 4 N. R. 7 E  
3 1/2 miles NNW of Summit  
(distance) (direction) (nearest town)

WELL PURPOSE: Home  
(home, irrigation, municipal, industrial)

- WELL COMPLETION DATA:
- (1) diameter (inches) 4"
  - (2) total depth (feet) 92
  - (3) static water level (feet) 73 below top of ground.
  - (4) casing Plast-Bottom  
(material) (depth)
  - if telescope see back.  
(size)
  - (5) screen 6' 86'  
(length) (depth to top)
  - 4" Plastic  
(size) (material)
  - (6) pump 1/2 Sub 12  
(HP) (yield gpm)
  - Electric  
(type power)
  - (7) electric log No  
(yes or no)
  - (organization running log)


**CODED**

(8) how well bottom plugged wooden plug  
DRILLERS REMARKS: New location

DEC 4 1972

If well telescopes please sketch and show depths.

GROUND LEVEL

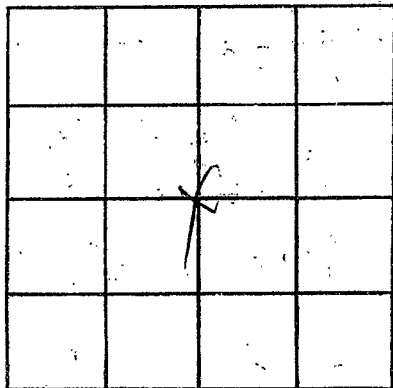

SECTION 3

Please indicate well location X.

ADDITIONAL INFORMATION

If more than one screen, show locations of each on sketch.