

Pike  
 A143  
 10-6-72

MISSISSIPPI  
 BOARD OF WATER COMMISSIONERS  
 416 North State Street  
 Jackson, Mississippi 39201

CODED


WATER WELL DRILLERS LOG

6 Oct 1972 date well completed  
 A. T. Conington Pumps firm name  
 Pikes county well located

LANDOWNER:	description of formations encountered	from	to
Carl Brown			
Summit (mailing address)	Clay Chalk Sand Chalk Sand	0 25 65 75	75 68 75 105
<b>WELL LOCATION:</b> sec. 27 T4 N R 7 E 3 miles West of Summit (distance) (direction) (nearest town)			
<b>WELL PURPOSE:</b> (home, irrigation, municipal, industrial)			
<b>WELL COMPLETION DATA:</b> (1) diameter (inches) 4 (2) total depth (feet) 105 (3) static water level (feet) 80 below top of ground. (4) casing RI 99 (material) (depth) (size) if telescope see back. (5) screen 6 99 (length) (depth to top) 4 (size) RI (material) (6) pump 1/2 8 (HP) (yield gpm) Elect (type power) (7) electric log (yes or no) (organization running log) (8) how well bottom plugged Wood	CODED		
<b>DRILLERS REMARKS:</b>	NOV 9 1972		

If well telescopes please sketch and show depths.

GROUND LEVEL

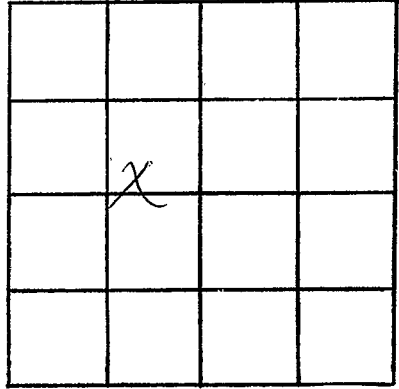

SECTION 27

Please indicate well location X.

ADDITIONAL INFORMATION

If more than one screen, show locations of each on sketch.