

Pike
A 144
11-23-72

MISSISSIPPI
BOARD OF WATER COMMISSIONERS
416 North State Street
Jackson, Mississippi 39201

COPIED


WATER WELL DRILLERS LOG

23 Nov 1977 77 ft. Huntington Pike
date well completed firm name county well located

| LANDOWNER: | description of formations encountered | from | to |
|---|---------------------------------------|---------------|----------------|
| F. J. Hutson | | | |
| Permitt (mailing address) | Clay Sed. rock Sand | 0 15 25 | 05 25 68 |
| WELL LOCATION: sec. 1 T 4 N R 7 E 1 miles S of Slaters (distance) (direction) (nearest town) | | | |
| WELL PURPOSE: (home, irrigation, municipal, industrial) | | | |
| WELL COMPLETION DATA: (1) diameter (inches) 4 (2) total depth (feet) 68 (3) static water level (feet) 25 below above top of ground. (4) casing 81, 62 (material), (depth) if telescope see back. (size) (5) screen 6, 62 (length), (depth to top) 4, 81 (size), (material) (6) pump 1/2, 5 (HP), (yield gpm) 912 (type power) (7) electric log (yes or no) (organization running log) (8) how well bottom plugged wood | | | |
| DRILLERS REMARKS: | EX-10 10 1977 | | |

If well telescopes please sketch and show depths.

GROUND LEVEL

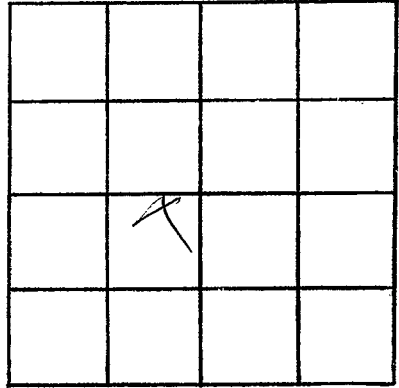

SECTION 1

Please indicate well location X.

ADDITIONAL INFORMATION

If more than one screen,
show locations of each on sketch.