

Pike  
A145  
11-11-72

MISSISSIPPI  
BOARD OF WATER COMMISSIONERS  
416 North State Street  
Jackson, Mississippi 39201

**CODED**

WATER WELL DRILLERS LOG

Nov 11 1972 Chester Keenan Pike  
date well completed firm name county well located

LANDOWNER: Charles  
Keenan  
RFD Summit  
(mailing address)

description of formations encountered	from	to
<u>Red Clay</u>	<u>0</u>	<u>7</u>
<u>Red Sand</u>	<u>7</u>	<u>50</u>
<u>Sandy Sand</u>	<u>50</u>	<u>72</u>
<u>Sand &amp; gravel</u>	<u>72</u>	<u>84</u>

WELL LOCATION:  
sec. 23 T 4 N R 7 E  
1 miles N of Summit  
(distance) (direction) (nearest town)

WELL PURPOSE: Home  
(home, irrigation, municipal, industrial)

- WELL COMPLETION DATA:
- (1) diameter (inches) 14"
  - (2) total depth (feet) 84
  - (3) static water level (feet) 119 below top of ground.
  - (4) casing Plast Bottom  
(material) (depth)
  - (size) if telescope see back.
  - (5) screen 6' 78"  
(length) (depth to top)
  - 14" Plast  
(size) (material)
  - (6) pump 1/2 hp 6  
(HP) (yield gpm)
  - 2300  
(type power)
  - (7) electric log no  
(yes or no)
  - (organization running log)


**CODED**

(8) how well bottom plugged  
wood plugs

DRILLERS REMARKS:  
New house

If well telescopes please sketch and show depths.

GROUND LEVEL

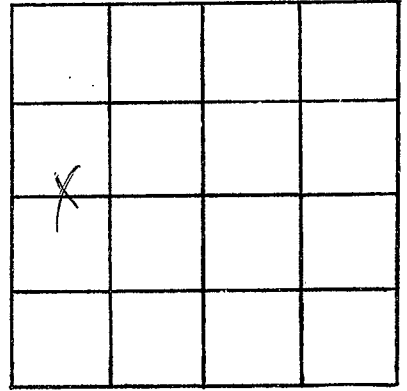

SECTION 23

Please indicate well location X.

ADDITIONAL INFORMATION

If more than one screen, show locations of each on sketch.