

Pike  
A 146  
1-18-73

MISSISSIPPI  
BOARD OF WATER COMMISSIONERS  
416 North State Street  
Jackson, Mississippi 39201

**CODED**

WATER WELL DRILLERS LOG


18 June 1973 date well completed  
J.T. Co. firm name  
Pike county well located

LANDOWNER:	description of formations encountered	from	to
Kenneth Leggett	Clay	0	15
Summit (mailing address)	Chalk Sand Sand Chalk Sand	15 35 45 60	25 45 60 87
<b>WELL LOCATION:</b> sec. <u>7</u> T <u>4</u> N R <u>7</u> E <u>4</u> miles <u>W</u> of <u>Summit</u> (distance) (direction) (nearest town)			
<b>WELL PURPOSE:</b> (home, irrigation, municipal, industrial)			
<b>WELL COMPLETION DATA:</b> (1) diameter (inches) <u>4</u> (2) total depth (feet) <u>87</u> (3) static water level (feet) <u>65</u> below above top of ground. (4) casing <u>PI</u> <u>81</u> (material) (depth) _____ If telescope see back. (size) (5) screen <u>6</u> <u>81</u> (length) (depth to top) <u>4</u> _____ (size) (material) (6) pump <u>6</u> <u>8</u> (HP) (yield gpm) <u>elect</u> (type power) (7) electric log _____ (organization running log) (8) how well bottom plugged <u>wood</u>			
<b>DRILLERS REMARKS:</b>			

**CODED**

If well telescopes please sketch and show depths.

GROUND LEVEL

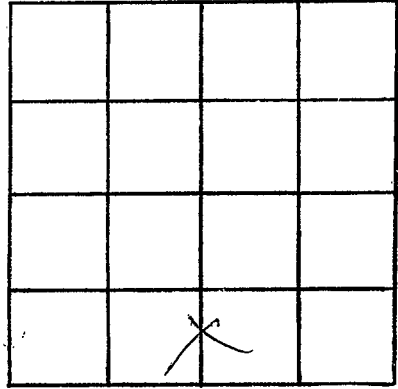

SECTION 7

Please indicate well location X.

ADDITIONAL INFORMATION

If more than one screen,  
show locations of each on sketch.