

Pike
A 147
1-18-73

MISSISSIPPI
BOARD OF WATER COMMISSIONERS
416 North State Street
Jackson, Mississippi 39201

CODED

WATER WELL DRILLERS LOG

18 Jan 1973 J.T. Covington Pike
date well completed firm name county well located

LANDOWNER:
W.T. Jackson
Summit
(mailing address)

description of formations encountered	from	to
Clay	0	20
chert	20	45
gal. flint	45	76

WELL LOCATION:
sec. 21 T. 4 (N) R. 7 (E)
2 miles W of Summit
(distance) (direction) (nearest town)

WELL PURPOSE:
(home, irrigation, municipal, industrial)

WELL COMPLETION DATA:

(1) diameter (inches) 4

(2) total depth (feet) 76

(3) static water level (feet) 60 below top of ground.

(4) casing (material) 70 (depth)
if telescope see back.
(size)

(5) screen 6 70
(length) (depth to top)
(size) (material)

(6) pump 1/2 8
(HP) (yield gpm)
elect (type power)

(7) electric log (yes or no)

(organization running log)


(8) how well bottom plugged wood

CODED

DRILLERS REMARKS:

If well telescopes please sketch and show depths.

GROUND LEVEL

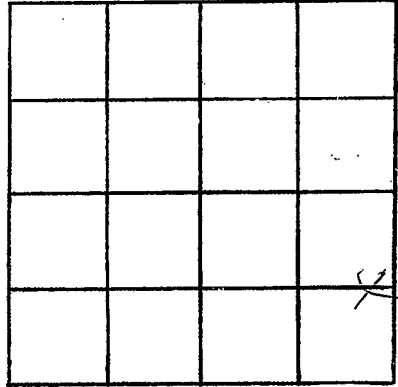

SECTION 21

Please indicate well location X.

ADDITIONAL INFORMATION

If more than one screen,
show locations of each on sketch.