

Pike
A148
3-14-73

MISSISSIPPI
BOARD OF WATER COMMISSIONERS
416 North State Street
Jackson, Mississippi 39201

CODED

WATER WELL DRILLERS LOG

March 14 1973 date well completed
Chester Keener firm name
Pike county well located

LANDOWNER: Ellis Jackson
(mailing address)

description of formations encountered	from	to
Red clay	0	18
Red sand	18	63
Sand & gravel	63	70
Loblolly sand	70	82
Small gravel sand	82	92

WELL LOCATION:
sec. 20 T. 4 N R. 7 E
3 miles WNW of Summit
(distance) (direction) (nearest town)

WELL PURPOSE: House
(home, irrigation, municipal, industrial)

- WELL COMPLETION DATA:
- (1) diameter (inches) 4"
 - (2) total depth (feet) 92
 - (3) static water level (feet) 60 below top of ground.
 - (4) casing Plast Bottom
(material) (depth)
4" if telescope see back. (size)
 - (5) screen 6' 86'
(length) (depth to top)
4" Plast
(size) (material)
 - (6) pump by others
(HP) (yield gpm)
(type power)
 - (7) electric log NO
(yes or no)
(organization running log)

CODED


(8) how well bottom plugged
wooden plug

DRILLERS REMARKS:
New house

APR 6 1973

If well telescopes please sketch and show depths.

GROUND LEVEL

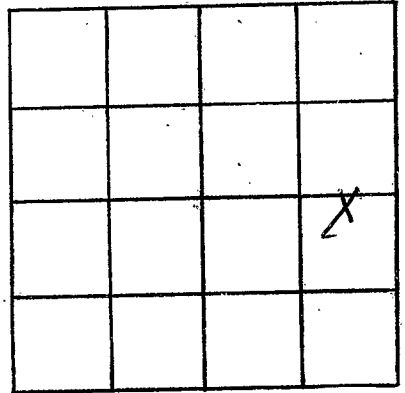

SECTION 3

Please indicate well location X.

ADDITIONAL INFORMATION

If more than one screen,
show locations of each on sketch.