

Pike
A149
2-14-73

MISSISSIPPI
BOARD OF WATER COMMISSIONERS
416 North State Street
Jackson, Mississippi 39201.

WATER WELL DRILLERS LOG

CODED

14 Feb 1973 J.T. Livingston Pike
date well completed firm name county well located

LANDOWNER: McComb Land
McComb
(mailing address)

description of formations encountered

from	to
0	25
25	60
60	76

Clay
Sandstone
Red shale

WELL LOCATION:
sec 35 T4 N R 7 E
1 miles S of Summit
(distance) (direction) (nearest town)

WELL PURPOSE:
(home, irrigation, municipal, industrial)

WELL COMPLETION DATA:

(1) diameter (inches) 4

(2) total depth (feet) 96

(3) static water level (feet) 60 below above top of ground.

(4) casing pl 90
(material) (depth)

 if telescope see back.
(size)

(5) screen 6 90
(length) (depth to top)

4 pl
(size) (material)

(6) pump 1/2 3
(HP) (yield gpm)

elect
(type power)

(7) electric log
(yes or no)

(organization running log)

(8) how well bottom plugged used


CODED

MAY 7 1973

DRILLERS REMARKS:

If well telescopes please sketch and show depths.

GROUND LEVEL

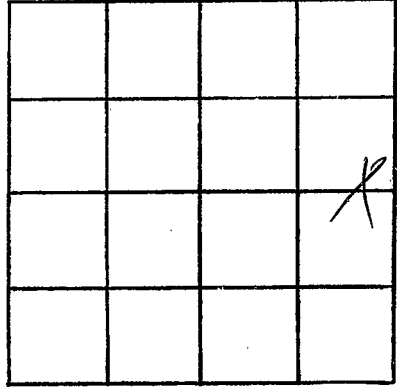

SECTION 35

Please indicate well location X.

ADDITIONAL INFORMATION

If more than one screen,
show locations of each on sketch.