

PIKE  
A150  
2-21-73

MISSISSIPPI  
BOARD OF WATER COMMISSIONERS  
416 North State Street  
Jackson, Mississippi 39201

**CODED**

WATER WELL DRILLERS LOG

21 Feb 1973 date well completed  
J. T. Gungatator firm name  
Pike county well located


LANDOWNER:	description of formations encountered	from	to
Oscar Hughes Summit (mailing address)	Clay Red clay pits Blue sand Tard	0 15 35 55	15 35 55 88
WELL LOCATION: sec. 2 T 4 N R 7 E 5 miles N of Summit (distance) (direction) (nearest town)			
WELL PURPOSE: (home, irrigation, municipal, industrial)			
WELL COMPLETION DATA:			
(1) diameter (inches) 4			
(2) total depth (feet) 88			
(3) static water level (feet) 60 below above top of ground.			
(4) casing PL 82 (material) (depth)	<b>CODED</b>		
(size) If telescope see back.			
(5) screen 6 82 (length) (depth to top)			
(size) PL (material)			
(6) pump 1/2 8 (HP) (yield gpm)			
Blert. (type power)			
(7) electric log (yes or no)			
(organization running log)			
(8) how well bottom plugged wood			
DRILLERS REMARKS:			

MAR 7 1973

MADE BY  
DATED

If well telescopes please sketch and show depths.

GROUND LEVEL

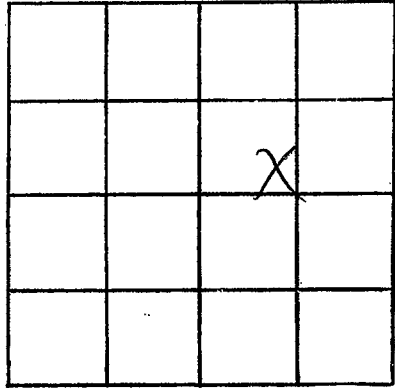

SECTION 2

Please indicate well location X.

ADDITIONAL INFORMATION

If more than one screen,  
show locations of each on sketch.