

PIKE

A 151

7-23-73

MISSISSIPPI BOARD OF WATER COMMISSIONERS
416 North State Street
Jackson, Mississippi 39201

CODED

WATER WELL DRILLERS LOG

28 April 1973

J.T. Covington & Son

Pike

LANDOWNER:

J. Brown

(mailing address)

description of formations encountered

from

to

clay sand

0 10
10 40

WELL LOCATION:

sec. 10 T 4 N R 7 E
5 miles N of Summit
(distance) (direction) (nearest town)

WELL PURPOSE:

(home, irrigation, municipal, industrial)

WELL COMPLETION DATA:

- (1) diameter (inches) 4
- (2) total depth (feet) 40
- (3) static water level (feet) 20 below top of ground.
- (4) casing 1" (material), 34 (depth)

If telescope see back.
(size)

- (5) screen 6 (length), 34 (depth to top)
- 4 (size), 1" (material)

- (6) pump 1/2 (HP), 8 (yield gpm)
- split (type power)

- (7) electric log (yes or no)

(organization running log)

- (8) how well bottom plugged wood


DRILLERS REMARKS:

CODED

JUN 17 1973

If well telescopes please sketch and show depths.

GROUND LEVEL

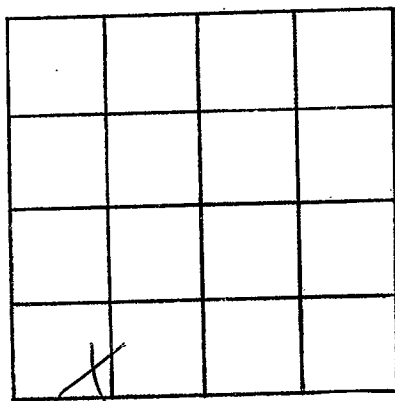

SECTION 10

Please indicate well location X.

ADDITIONAL INFORMATION

If more than one screen, show locations of each on sketch.