

PIKE
A 152
7-23-73

MISSISSIPPI
BOARD OF WATER COMMISSIONERS
416 North State Street
Jackson, Mississippi 39201

WATER WELL DRILLERS LOG

CODED

30 May 1973 date well completed
J.T. Crumpton, P.K.L. firm name
Pike county well located

LANDOWNER:
Clark Whitehead
Summit
(mailing address)

description of formations encountered	from	to
clay	0	20
clay sand	20	45
chert	45	60
sand	60	92

WELL LOCATION:
sec. 30 T. 4 N R. 7 E
4 miles W of Summit
(distance) (direction) (nearest town)

WELL PURPOSE:
(home, irrigation, municipal, industrial)

- WELL COMPLETION DATA:
- (1) diameter (inches) _____
 - (2) total depth (feet) 92
 - (3) static water level (feet) 70 below above top of ground.
 - (4) casing PI 88
(material) (depth)
_____ if telescope see back.
(size)
 - (5) screen 6 86
(length) (depth to top)
4 PI
(size) (material)
 - (6) pump 6 8
(HP) (yield gpm)
split
(type power)
 - (7) electric log _____
(yes or no)
 - _____ (organization running log)
 - (8) how well bottom plugged good

CODED


MAY 17 1973

DRILLERS REMARKS:

MISS. BD. OF
WATER COMMISSIONERS

If well telescopes please sketch and show depths.

GROUND LEVEL

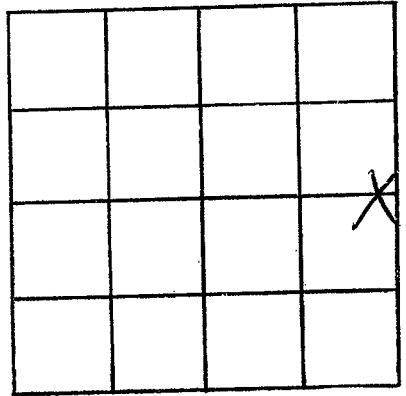

SECTION 30

Please indicate well location X.

ADDITIONAL INFORMATION

If more than one screen,
show locations of each on sketch.