

A153
 PIKE
 7-9-73

MISSISSIPPI
 BOARD OF WATER COMMISSIONERS
 416 North State Street
 Jackson, Mississippi 39201

CODED

WATER WELL DRILLERS LOG

July 9 1973 *Chester Keener* *Ribe*
 date well completed firm name county well located

LANDOWNER: *James Lester*
Archie
Rt 4 Summit
 (mailing address)

WELL LOCATION:
 sec. 27 T. 4 N. R. 7 E
4 miles N of Summit
 (distance) (direction) (nearest town)

WELL PURPOSE: *Household*
 (home, irrigation, municipal, industrial)

- WELL COMPLETION DATA:
- (1) diameter (inches) 4"
 - (2) total depth (feet) 95
 - (3) static water level (feet) 65 below above top of ground.
 - (4) casing Plast, Ballou's
 (material) (depth)
 - if telescope see back.
 (size)
 - (5) screen 6', 89'
 (length) (depth to top)
 - 4", Plast
 (size) (material)
 - (6) pump 1/2 HP, 12
 (type power) (yield gpm)
 - (7) electric log No
 (yes or no)
 - (organization running log)

description of formations encountered	from	to
<i>Sandy clay</i>	<i>0</i>	<i>20</i>
<i>Sand & gravel</i>	<i>20</i>	<i>56</i>
<i>Red chalk</i>	<i>56</i>	<i>72</i>
<i>Chalk & Sand</i>	<i>72</i>	<i>90</i>
<i>Small pebbles & Sand</i>	<i>90</i>	<i>95</i>

CODED


(8) how well bottom plugged wooden plug

DRILLERS REMARKS: new house

AUG 20 1973

If well telescopes please sketch and show depths.

GROUND LEVEL

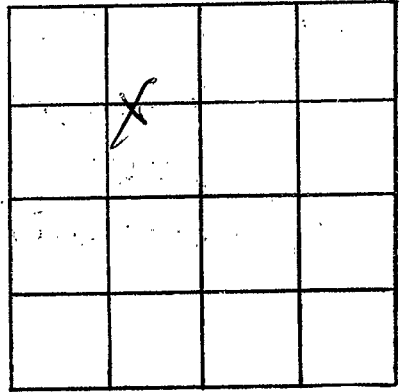

SECTION 9

Please indicate well location X.

ADDITIONAL INFORMATION

If more than one screen, show locations of each on sketch.