

PIKE
AISA

MISSISSIPPI
BOARD OF WATER COMMISSIONERS
416 North State Street
Jackson, Mississippi 39201

CODED 73

WATER WELL DRILLERS LOG

MISS. NO. OF
WELL

7-28-73

28 July 1973
date well completed

J. I. Corington
firm name

(Pike)
county well located

LANDOWNER:

Noah Andrews

description of formations encountered

from to

Clay dirt	0	25
Chalk	25	45
Sand Pea Gravel	45	53
Chalk	53	65
Sand	65	100

(mailing address)

WELL LOCATION:

sec 6 T 4 N R 7 E
7 miles N West of Summit
(distance) (direction) (nearest town)

WELL PURPOSE:

(home, irrigation, municipal, industrial)

WELL COMPLETION DATA:

- (1) diameter (inches) 4
- (2) total depth (feet) 100
- (3) static water level (feet) 70 below above top of ground.
- (4) casing PI 94
(material) (depth)
- if telescope see back.
(size)
- (5) screen 6 94
(length) (depth to top)
- 4 PI
(size) (material)
- (6) pump 1/2 8
(HP) (yield gpm)
- Electric
(type power)
- (7) electric log
(yes or no)


(organization running log)

(8) how well bottom plugged wood

DRILLERS REMARKS:

If well telescopes please sketch and show depths.

GROUND LEVEL

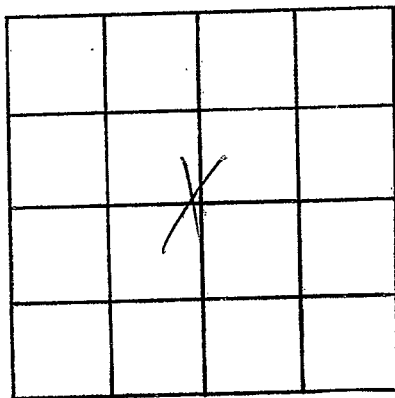

SECTION 6

Please indicate well location X.

ADDITIONAL INFORMATION

If more than one screen, show locations of each on sketch.