

PIKE

A 155

E Log #128

12/73

1973

MISSISSIPPI
BOARD OF WATER COMMISSIONERS **CODED**
416 North State Street
Jackson, Mississippi 39201

WATER WELL DRILLERS LOG

date well completed

firm name

county well located

1973 KRINER DRILLING SERVICE PIKE

LANDOWNER: NORTH PIKE

description of formations encountered

from to

WATER ASSN., WELL NO. 1

(mailing address)

WELL LOCATION: SEA NE 1/4

sec. 24 T. 4 N. S. R. 7 E. W.

(distance) miles (direction) of (nearest town)

WELL PURPOSE: (home, irrigation, municipal, industrial)

WELL COMPLETION DATA:

(1) diameter (inches) 10 3/4"
(2) total depth (feet) 168'
(3) static water level (feet) 85' below top of ground.

(4) casing B.I., 1 1/2' (material) (depth)

10 3/4" if telescope see back. (size)

(5) screen 40', 126' (length) (depth to top)

8", 304 SS. - .010 (size) (material)

(6) pump Elect, 175 (HP) (yield gpm)

Elect (type power)

(7) electric log Yes (yes or no)


MGS (organization running log)

(8) how well bottom plugged Back
Wash Valve

DRILLERS REMARKS:

description of formations encountered	from	to
TOP SOIL	0	3
Tuffaceous Clay	3	10
Sand + Gravel	10	90
Clay	90	115
Sand & fine gravel (str.)	115	168
Clay	168	216
Sand, Fine	216	235
Clay	235	268
Sand, Fine	268	290
Clay	290	598
Sand, Fine	598	628
Clay	628	700

CODED

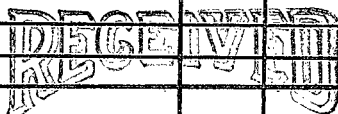

JUL - 1974

