

PIKE
 A 156
 8-30-73

MISSISSIPPI
 BOARD OF WATER COMMISSIONERS
 416 North State Street
 Jackson, Mississippi 39201

CODED

WATER WELL DRILLERS LOG

8-30

1973

Fitzgerald Well Co

Pike

date well completed

firm name

county well located

LANDOWNER:

C. R. Corbin

description of formations encountered

from

to

R. R. Summit (mailing address)

Red clay 0 20
 Red gravel 20 90
 Coarse sand & gravel 90 104

WELL LOCATION:

sec. 19 T. 4 N. R. 7 E.

4 miles W of Summit (distance) (direction) (nearest town)

WELL PURPOSE:

(home, irrigation, municipal, industrial) Home

WELL COMPLETION DATA:

CODED


- (1) diameter (inches) 4
- (2) total depth (feet) 104
- (3) static water level (feet) 70 below above top of ground.
- (4) casing (material) plastic, 96 (depth) (size) 4 if telescope see back.
- (5) screen (length) 8, (depth to top) 96 (size) 4, (material) plastic
- (6) pump (HP) 1/2, (yield gpm) 10 (type power) elec
- (7) electric log (yes or no) no
- (organization running log)
- (8) how well bottom plugged gravel plug

DRILLERS REMARKS:

OCT 9 1973

If well telescopes please
sketch and show depths.

GROUND LEVEL

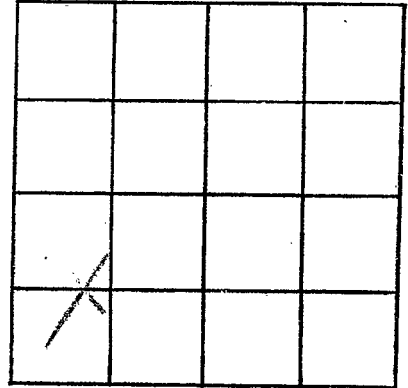

SECTION 19

Please indicate well location X.

ADDITIONAL INFORMATION

If more than one screen,
show locations of each on sketch.