

PIKE
A158
8-27-73

MISSISSIPPI
BOARD OF WATER COMMISSIONERS
416 North State Street
Jackson, Mississippi 39201

CODED

WATER WELL DRILLERS LOG

Aug 27 1973 Chatter Keener Pike
date well completed firm name county well located

LANDOWNER: Emmie Reed
H D Summit

description of formations encountered	from	to
Red clay	0	18
Red sandy clay	18	72
Sand & fine gravel	72	94
Coarse sand & pea gravel	94	104

(mailing address)

WELL LOCATION:
sec. 21 T. 4 N R. 7 E
2 1/2 miles W of Summit
(distance) (direction) (nearest town)

WELL PURPOSE: house
(home, irrigation, municipal, industrial)

WELL COMPLETION DATA:

- (1) diameter (inches) 4'
- (2) total depth (feet) 104
- (3) static water level (feet) 68 below above top of ground.
- (4) casing Plast Bottom
(material) (depth)
- _____ if telescope see back.
(size)
- (5) screen 6' 98'
(length) (depth to top)
- 4" Plast
(size) (material)
- (6) pump 1/2 HP 6
(type power) (yield gpm)
- elect
- (7) electric log NO
(yes or no)

CODED

(organization running log)


(8) how well bottom plugged wooden plug

DRILLERS REMARKS: New house

RDW 7 1973

If well telescopes please sketch and show depths.

GROUND LEVEL

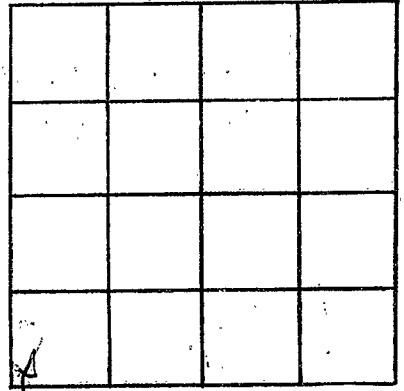

SECTION 21

Please indicate well location X.

ADDITIONAL INFORMATION

If more than one screen,
show locations of each on sketch.