

PIKE
A159
10-13-73

MISSISSIPPI
BOARD OF WATER COMMISSIONERS
416 North State Street
Jackson, Mississippi 39201

CODED

WATER WELL DRILLERS LOG

Oct 13 1973 Chester Keener Ritko
date well completed firm name county well located

LANDOWNER: Glover B. Freeman
Rt. 4, Summit
(mailing address)

WELL LOCATION:
sec. 32 4 N R 7 E
3/4 miles W of Plant
(distance) (direction) (nearest town)

WELL PURPOSE: drill
(home, irrigation, municipal, industrial)

WELL COMPLETION DATA:

- (1) diameter (inches) 4"
- (2) total depth (feet) 104'
- (3) static water level (feet) 77 below top of ground
- (4) casing Plast. bottom
(material) (depth)
- _____ if telescope see back.
(size)
- (5) screen 6' 98'
(length) (depth to top)
- 4" Plast
(size) (material)
- (6) pump owners all pump.
(HP) (yield gpm)
- _____ (type power)
- (7) electric log NO
(yes or no)
- _____ (organization running log)
- (8) how well bottom plugged wooden plug

description of formations encountered	from	to
Clay	0	17
Red sand & gravel	17	48
Labelly chalk	48	86
Sand gravel	86	98
	98	104

CODED


DRILLERS REMARKS: all
well had

NOV 7 1973

MISS. Bd. OF WATER COMM.

If well telescopes please sketch and show depths.

GROUND LEVEL

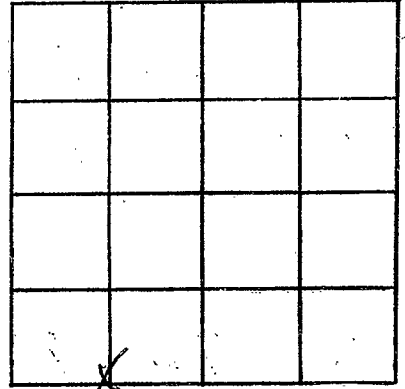

SECTION 32

Please indicate well location X.

ADDITIONAL INFORMATION

If more than one screen, show locations of each on sketch.