

PIKE
A 160
10-26-73

MISSISSIPPI
BOARD OF WATER COMMISSIONERS
416 North State Street
Jackson, Mississippi 39201

CODED

WATER WELL DRILLERS LOG

Oct 26 1973 Chester Keener Pike
date well completed firm name county well located

LANDOWNER Ermy Hackett
Summit

description of formations encountered	from	to
Red clay	0	14
Red sand	14	30
Sand gravel	30	45
lobbley	45	88
Small gravel	88	94

(mailing address)

WELL LOCATION:
sec. 23 T 4 N R 7 E
1/2 miles W of Summit
(distance) (direction) (nearest town)

WELL PURPOSE: House
(home, irrigation, municipal, industrial)

WELL COMPLETION DATA:

- (1) diameter (inches) 4"
- (2) total depth (feet) 94
- (3) static water level (feet) 47 below top of ground.
- (4) casing Plast Bottom
(material) (depth)

_____ if telescope see back.
(size)

- (5) screen 6' 88'
(length) (depth to top)

4" Plast
(size) (material)

- (6) pump 1/2 HP 15
(HP) (yield gpm)

elect
(type power)

- (7) electric log no
(yes or no)

_____ (organization running log)

- (8) how well bottom plugged wood plug

DRILLERS REMARKS:
new house.


CODED

NOV 7 1973

MISS. SD. OF
WATER COMMISSIONERS

If well telescopes please
sketch and show depths.

GROUND LEVEL

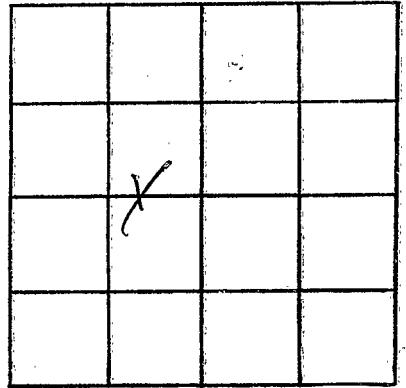

SECTION 23

Please indicate well location X.

ADDITIONAL INFORMATION

If more than one screen,
show locations of each on sketch.