

PIKE
A 163
12-5-73

MISSISSIPPI
BOARD OF WATER COMMISSIONERS
416 North State Street
Jackson, Mississippi 39201

CODED

WATER WELL DRILLERS LOG

5 Dec 1973 J. T. Carington Pike
date well completed firm name county well located

LANDOWNER:

Don of Amborough
Summit
(mailing address)

description of formations encountered

from to

Clay
sand rock 0 10
10 41

WELL LOCATION:

sec. 10 T. 4 N R. 7 E
5 miles N of Summit
(distance) (direction) (nearest town)

WELL PURPOSE:

(home, irrigation, municipal, industrial)

WELL COMPLETION DATA:

- (1) diameter (inches) 4
(2) total depth (feet) 41
(3) static water level (feet) 20 below top of ground.
(4) casing PL, 35 (material), (depth)
(size) if telescope see back.
(5) screen 6, 35 (length), (depth to top)
(size), (material)
(6) pump 1/2 (HP), 8 (yield gpm)
elect (type power)
(7) electric log (yes or no)

(organization running log)

(8) how well bottom plugged Wood

CODED


INDEXED
SERIALIZED
FEB 19 1974

DRILLERS REMARKS:

MISS. BD. OF WATER COMMISSIONERS

If well telescopes please sketch and show depths.

GROUND LEVEL

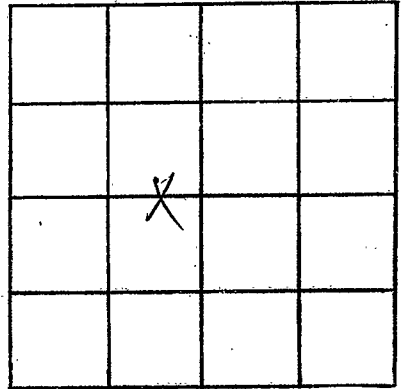

SECTION 10

Please indicate well location X.

ADDITIONAL INFORMATION

If more than one screen, show locations of each on sketch.