

PIKE
A 164
3-7-74

MISSISSIPPI
BOARD OF WATER COMMISSIONERS
416 North State Street
Jackson, Mississippi 39201

CODED

WATER WELL DRILLERS LOG

7 March 1974 J.T. Carington Son Pike
date well completed firm name county well located

LANDOWNER:
Frank Singleton
Summit
(mailing address)

description of formations encountered	from	to
Clay	0	25
Chalk	25	45
Red shale	45	94


WELL LOCATION:
sec. 6 T. 4 N. R. 7 E
5 miles NW of Summit
(distance) (direction) (nearest town)

WELL PURPOSE:
(home, irrigation, municipal, industrial)

- WELL COMPLETION DATA:
- (1) diameter (inches) 4
 - (2) total depth (feet) 94
 - (3) static water level (feet) 70 below top of ground.
 - (4) casing (material) PL (depth) 88
(size) If telescope see back.
 - (5) screen (length) 6 (depth to top) 88
(size) 4 (material) PL
 - (6) pump (HP) 1/2 (yield gpm) 3
(type power) elect
 - (7) electric log (yes or no)
 - (organization running log)
 - (8) how well bottom plugged wood

CODED

DRILLERS REMARKS:

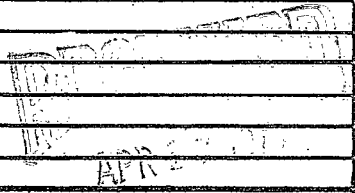

MISS. BD. OF WATER COMMISSIONERS

