

PIKE
A 165
2-1-74

MISSISSIPPI
 BOARD OF WATER COMMISSIONERS
 416 North State Street
 Jackson, Mississippi 39201
WATER WELL DRILLERS LOG

CODED

1 Feb 74 1974 date well completed
 J. C. Co. firm name
 Pike county well located

LANDOWNER:
 H. M. Freeman
 Summit
 (mailing address)

description of formations encountered	from	to
clay	0	20
red clay	20	60
sand	100	87

WELL LOCATION:
 sec. 17 T. 4 N. R. 7 E
 5 miles W of Emerald
 (distance) (direction) (nearest town)

WELL PURPOSE:
 (home, irrigation, municipal, industrial)

WELL COMPLETION DATA:

(1) diameter (inches) 4

(2) total depth (feet) 83

(3) static water level (feet) 65 below top of ground.

(4) casing PL, 77 (material), (depth)

_____ If telescope see back.
 (size)

(5) screen 6, 77 (length), (depth to top)

4, PL (size), (material)

(6) pump 1/2 (HP), 8 (yield gpm)

electric (type power)


(7) electric log _____ (yes or no)

_____ (organization running log)

(8) how well bottom plugged well

CODED

DRILLERS REMARKS:

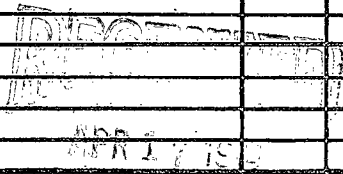

If well telescopes please sketch and show depths.

GROUND LEVEL

			X

SECTION 17

Please indicate well location X.

ADDITIONAL INFORMATION

If more than one screen, show locations of each on sketch.