

PIKE

ALL

9-13-73

MISSISSIPPI BOARD OF WATER COMMISSIONERS 416 North State Street Jackson, Mississippi 39201

CODED

WATER WELL DRILLERS LOG

Sept 13 1973 date well completed Chester Keenes firm name Pike county well located

LANDOWNER: R. W. Lyles RFD Summit

description of formations encountered	from	to
clay	0	18
Red Sand	18	76
Coarse Sand	76	100

(mailing address)

WELL LOCATION:

sec. 18 T. 4 N R. 7 E 4 miles NW of Summit

WELL PURPOSE: Home - Dring (home, irrigation, municipal, industrial)


WELL COMPLETION DATA:

- (1) diameter (inches) 4"
- (2) total depth (feet) 100
- (3) static water level (feet) 54 below top of ground
- (4) casing Plast Ballon (material) (depth)
- (5) screen 6" 94 (length) (depth to top) 4" Plast (size) (material)
- (6) pump 1/2 HP 15 (yield gpm) Elec (type power)
- (7) electric log No (yes or no)

CODED

(organization running log)

DRILLERS REMARKS: Well Sanded

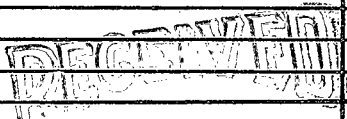


MAY 24 1974

MISSISSIPPI BOARD OF WATER COMMISSIONERS

If well telescopes please
sketch and show depths.

GROUND LEVEL

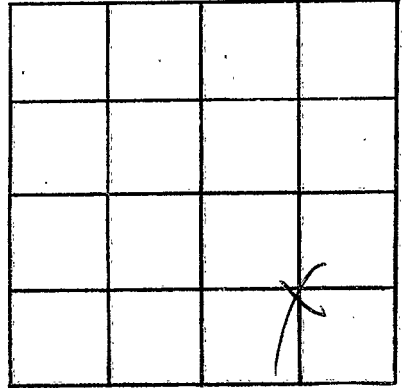

SECTION 18

Please indicate well location X.

ADDITIONAL INFORMATION

If more than one screen,
show locations of each on sketch.