

PIKE
A 167
7-22-74

MISSISSIPPI
BOARD OF WATER COMMISSIONERS
416 North State Street
Jackson, Mississippi 39201

CODED

WATER WELL DRILLERS LOG

7-22 1974 Hydrol Well Service Pike
date well completed firm name county well located

LANDOWNER:
Carey Smith
R.R. Summit Miss.
(mailing address)

description of formations encountered	from	to
<u>Red clay</u>	<u>0</u>	<u>20</u>
<u>Red sand</u>	<u>20</u>	<u>70</u>
<u>White chalk</u>	<u>70</u>	<u>100</u>
<u>Coarse sand</u>	<u>100</u>	<u>112</u>

WELL LOCATION:
sec. 21 T. 9N R. 7E
2 1/2 miles W of Summit
(distance) (direction) (nearest town)

WELL PURPOSE: Home
(home, irrigation, municipal, industrial)

- WELL COMPLETION DATA:
- (1) diameter (inches) 4
 - (2) total depth (feet) 112
 - (3) static water level (feet) 70 below above top of ground.
 - (4) casing plaster, 104,
(material) (depth)
4 if telescope see back.
(size)
 - (5) screen 8, 104
(length) (depth to top)
4, plaster
(size) (material)
 - (6) pump: 1/2 10
(HP) (yield gpm)
elm.
(type power)
 - (7) electric log no
(yes or no)
(organization running log)
 - (8) how well bottom plugged bedrock


DRILLERS REMARKS:

RECEIVED
AUG 26 1974

MISS. Bd. OF WATER CONTROL

If well telescopes please sketch and show depths.

GROUND LEVEL

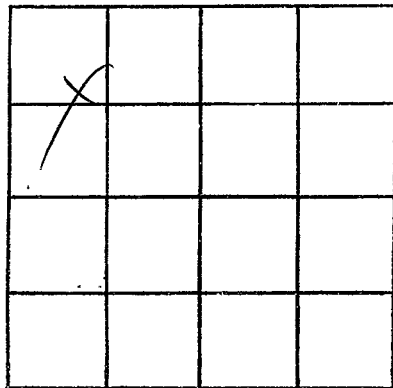

SECTION 31

Please indicate well location X.

ADDITIONAL INFORMATION

If more than one screen,
show locations of each on sketch.