

PIKE
A 168
9/30/79

MISSISSIPPI
BOARD OF WATER COMMISSIONERS
416 North State Street
Jackson, Mississippi 39201

WATER WELL DRILLERS LOG

CODED

9-30
date well completed

1979 *Fitzgerald Well Serv*
firm name

Pike
county well located

LANDOWNER:
Helen Higgins
R.R. Summit Miss.
(mailing address)

description of formations encountered	from	to
<i>Red clay</i>	<i>0</i>	<i>20</i>
<i>Red sand</i>	<i>20</i>	<i>105</i>
<i>Coarse sand & gravel</i>	<i>105</i>	<i>115</i>

WELL LOCATION:
sec. *4* T. *4* N. R. *20* E.
6 miles *N* of *Summit*
(distance) (direction) (nearest town)

WELL PURPOSE:
Home
(home, irrigation, municipal, industrial)


CODED

WELL COMPLETION DATA:
(1) diameter (inches) *4*
(2) total depth (feet) *115*
(3) static water level (feet) *70* below above top of ground.
(4) casing *plastic* (material), *107* (depth),
4 (size) if telescope see back.
(5) screen *8* (length), *107* (depth to top),
4 (size), *plastic* (material)
(6) pump *3/4* (HP), *6* (yield gpm),
60 (type power)
(7) electric log *no* (yes or no)

(organization running log)


(8) how well bottom plugged *sub shell*

DRILLERS REMARKS:

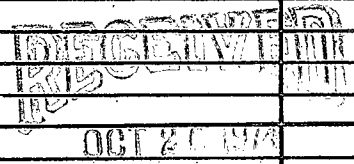

If well telescopes please sketch and show depths.

GROUND LEVEL

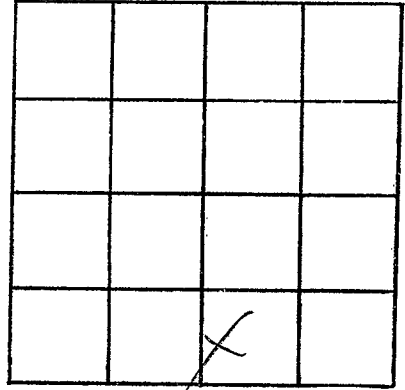

SECTION 4

Please indicate well location X.

ADDITIONAL INFORMATION

If more than one screen,
show locations of each on sketch.