

PIKE  
~~AS~~ A 169  
 12-31-74

MISSISSIPPI  
 BOARD OF WATER COMMISSIONERS  
 416 North State Street  
 Jackson, Mississippi 39201

WATER WELL DRILLERS CODED

30 Dec 1974 J. T. Coan, Jr. & Son Pike  
 date well completed firm name county well located

LANDOWNER: Alice Baker  
 Summit (mailing address)  
 description of formations encountered: Clay, Red Sand clay, Sand  
 from to: 0 25, 25 80, 80 94

WELL LOCATION:  
 sec. 4 T. 4 S. R. 7 E.  
 4 miles N of Summit  
 (distance) (direction) (nearest town)

WELL PURPOSE:  
 (home, irrigation, municipal, industrial)

WELL COMPLETION DATA:  
 (1) diameter (inches) 4  
 (2) total depth (feet) 84  
 (3) static water level (feet) 65 below top of ground  
 (4) casing (material) 88 (depth)  
 (size) If telescope see back.  
 (5) screen 6 88 (length) (depth to top)  
 (size) (material)  
 (6) pump 1/2 (HP) 80 (yield gpm)  
 (type power) AC  
 (7) electric log (yes or no)  
 (organization running log)  
 (8) how well bottom plugged wood

CODED

RECEIVED  
 MISS. BD. OF WATER COMMISSIONERS


JAN 20 1975

MISS. BD. OF WATER COMMISSIONERS

DRILLERS REMARKS:

If well telescopes please sketch and show depths.

GROUND LEVEL

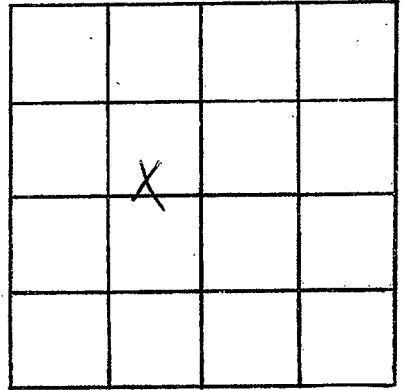

SECTION 4

Please indicate well location X.

ADDITIONAL INFORMATION

If more than one screen, show locations of each on sketch.