

PIKE
A170
1-15-75

MISSISSIPPI
BOARD OF WATER COMMISSIONERS
416 North State Street
Jackson, Mississippi 39201

CODED

WATER WELL DRILLERS LOG

15 Jan 1975 *J.T. Livingston* *Pike*
date well completed firm name county well located

LANDOWNER:
J.A. Handley
Sumner
(mailing address)

description of formations encountered	from	to
<i>clay</i>	<i>0</i>	<i>25</i>
<i>well sand clay</i>	<i>25</i>	<i>65</i>
<i>sand, part</i>	<i>65</i>	<i>75</i>
<i>sand</i>	<i>75</i>	<i>95</i>

WELL LOCATION:
sec. *31* T. *4* N. R. *7* E.
4 miles *W* of *Sumner*
(distance) (direction) (nearest town)

WELL PURPOSE:
(home, irrigation, municipal, industrial)

- WELL COMPLETION DATA:
- (1) diameter (inches) *4*
 - (2) total depth (feet) *95*
 - (3) static water level (feet) *70* below above top of ground.
 - (4) casing *pl* *89*
(material) (depth)
(size) if telescope see back.
 - (5) screen *6* *89*
(length) (depth to top)
u *pl*
(size) (material)
 - (6) pump *1/2* *8*
(HP) (yield gpm)
slut
(type power)
 - (7) electric log (yes or no)
 - (organization running log)
 - (8) how well bottom plugged *wood*


CODED

RECEIVED
APR - 7 1975

DRILLERS REMARKS:

If well telescopes please sketch and show depths.

GROUND LEVEL

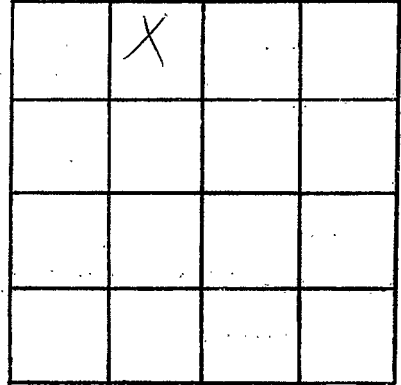

SECTION 31

Please indicate well location X.

ADDITIONAL INFORMATION

If more than one screen,
show locations of each on sketch.