

GOOD

PIKE
A171
4-11-75

MISSISSIPPI
BOARD OF WATER COMMISSIONERS
416 North State Street
Jackson, Mississippi 39201

WATER WELL DRILLERS LOG

pipe

April 11 1975 Chester Pines county well located

LANDOWNER:
Mr. Charles Boulin
Rt. Summit
(mailing address)

description of formations encountered	from	to
<u>Red Clay</u>	<u>0</u>	<u>12</u>
<u>pink chalk</u>	<u>12.65</u>	<u>74</u>
<u>sand gravel</u>	<u>74</u>	<u>110</u>
<u>pink sandy chalk</u>	<u>110</u>	<u>120</u>

WELL LOCATION:
sec. 3 T. 4 N R. 7 E
3 miles N of Summit
(distance) (direction) (nearest town)

WELL PURPOSE: Home
(home, irrigation, municipal, industrial)

- WELL COMPLETION DATA:
- (1) diameter (inches) 4"
 - (2) total depth (feet) 120
 - (3) static water level (feet) 49 below top of ground.
 - (4) casing plastic (material) bottom (depth)
 - no If telescope see back. (size)
 - (5) screen 6" (length) 114ft (depth to top)
 - 4" (size) plastic (material)
 - (6) pump 1 sub (HP) 10 (yield gpm)
 - list (type power)
 - (7) electric log no (yes or no)
 - (organization running log)

(8) how well bottom plugged wooden plug


DRILLERS REMARKS:
new house site

RECEIVED
MAY - 8 1975

MISS. BD. OF WATER COMMISSIONERS

If well telescopes please sketch and show depths.

GROUND LEVEL

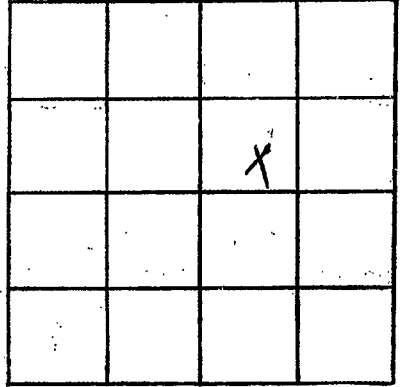

SECTION 3

Please indicate well location X.

ADDITIONAL INFORMATION

Lined area for additional information.

If more than one screen, show locations of each on sketch.