

PIKE  
A 172  
11/1/6  
E log #135

MISSISSIPPI  
 BOARD OF WATER COMMISSIONERS  
 416 North State Street  
 Jackson, Mississippi 39201

COLL

WATER WELL DRILLERS LOG

date well completed 1976 GRINER DRILLING SERVICE firm name PIKE county well located

LANDOWNER: TOWN OF SUMMIT  
Well no. 4  
 (mailing address)

description of formations encountered	from	to
Top Soil	0	3
CLAY w/sand streaks	3	35
SAND & Pea Gravel	35	95
CLAY	95	164
SAND	164	216
CLAY w/Rocks	216	504
SAND, Fine	504	530
SAND, Medium	530	570
CLAY	570	590

WELL LOCATION: NW 1/4 SE 1/4 SW 1/4  
 sec. 25 T. 4 N. R. 1 E  
 S. W.  
 (distance) miles of (direction) of (nearest town)

WELL PURPOSE:  
 (home, irrigation, municipal, industrial)

WELL COMPLETION DATA:

- (1) diameter (inches) 12 3/4
- (2) total depth (feet) 577
- (3) static water level (feet) 211.75 below top of ground.
- (4) casing steel, 505 (material) (depth)  
12 3/4 (size) if telescope see back.
- (5) screen 60, 512 (length) (depth to top)  
Johnson 8" (1020) 304 S.S. (size) (material)
- (6) pump 50, 500 (HP) (yield gpm)  
Elect. (type power)
- (7) electric log Yes (yes or no)  
MGS (organization running log)
- (8) how well bottom plugged BACK  
WASH

WELL NO. 4  
 NOV 24 1976

RECEIVED

NOV 24 1976


DRILLERS REMARKS:

PROD. BO. OF MISSISSIPPI

(2)

If well telescopes please sketch and show depths.

GROUND LEVEL

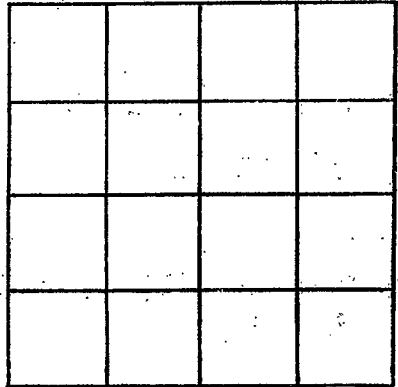

SECTION \_\_\_\_\_

Please indicate well location X.

ADDITIONAL INFORMATION

Lined area for recording additional information.

If more than one screen, show locations of each on sketch.