

PIKE
A 173
2/4/78

MISSISSIPPI
BOARD OF WATER COMMISSIONERS
416 North State Street
Jackson, Mississippi 39201

CODED

WATER WELL DRILLERS LOG

2/4/78 19 Graver Drilling Service Pike
date well completed firm name county well located

LANDOWNER: Cotton Petroleum Corp.
new + Hugel
#1 Stanley Roberts
(mailing address)

WELL LOCATION:
sec. 15 T. 4 N. R. 7 E
650' N + 1980' E of SW cor Summit
miles (distance) of (direction) (nearest town)

WELL PURPOSE: Oil Well Supply
(home, irrigation, municipal, industrial)

- WELL COMPLETION DATA:
- (1) diameter (inches) 3"
 - (2) total depth (feet) 550
 - (3) static water level (feet) 130 below above top of ground.
 - (4) casing Steel, 525,
(material) (depth)
 - _____ if telescope see back.
(size)
 - (5) screen 42', 483
(length) (depth to top)
 - 3", Perforated Pipe
(size) (material)
 - (6) pump _____, 75
(HP) (yield gpm)
 - AC
(type power)
 - (7) electric log NO
(yes or no)
 - NA
(organization running log)
 - (8) how well bottom plugged orange
Red


description of formations encountered	from	to
Clay + Sand	10	42
Gravel + Sand	42	275
Clay + Sand	275	460
Sand with (a few) Small streaks of Clay	460	530
Clay	530	550

DRILLERS REMARKS:

RECEIVED
MAR 10 1978

If well telescopes please sketch and show depths.

GROUND LEVEL

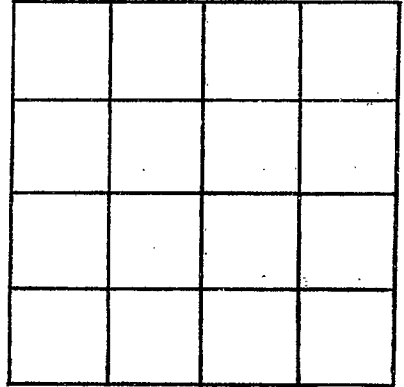

SECTION _____

Please indicate well location X.

ADDITIONAL INFORMATION

If more than one screen, show locations of each on sketch.