

PIKE
A 174
44-79

MISSISSIPPI
BOARD OF WATER COMMISSIONERS
416 North State Street
Jackson, Mississippi 39201

CODED

WATER WELL DRILLERS LOG

April 4 1979 River Well Drillers Pipe
date well completed firm name county well located

| LANDOWNER: | description of formations encountered | from | to |
|---------------------------------------------------------------------------------------------|---------------------------------------|------|----|
| J. K. River At Summit (mailing address) | | | |
| WELL LOCATION: | | | |
| sec. 19 T 4 N R 7 E 3 1/2 miles W. NW of Summit (distance) (direction) (nearest town) | | | |
| WELL PURPOSE: irrigation (home, irrigation, municipal, industrial) | | | |
| WELL COMPLETION DATA: | | | |
| (1) diameter (inches) 4" | | | |
| (2) total depth (feet) 184 | | | |
| (3) static water level (feet) 40 below top of ground. | | | |
| (4) casing plastic bottom (material) (depth) | | | |
| (5) screen 20' 164' (length) (depth to top) | | | |
| (6) pump 4 Sub 100 (size) (material) (HP) (yield gpm) | | | |
| (7) electric log NO (type power) (yes or no) | | | |
| (8) how well bottom plugged wooden plug | | | |
| DRILLERS REMARKS: | | | |

CODED


Miss. Board of Water Comm.

AUG 24 1979

RECEIVED

If well telescopes please sketch and show depths.

GROUND LEVEL

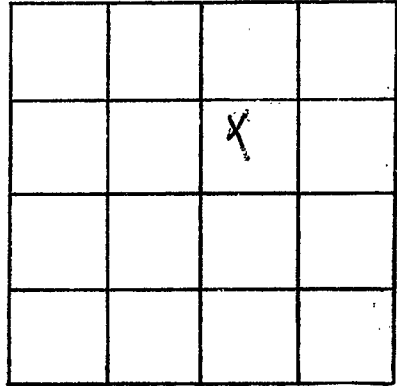

SECTION 19

Please indicate well location X.

ADDITIONAL INFORMATION

If more than one screen, show locations of each on sketch.