

MISSISSIPPI DEPARTMENT OF NATURAL RESOURCES

Bureau of Land and Water Resources


Southport Mall

P.O. Box 10631

Jackson, Mississippi 39209

WATER WELL DRILLERS LOG

Griner Drilling Service, Inc.

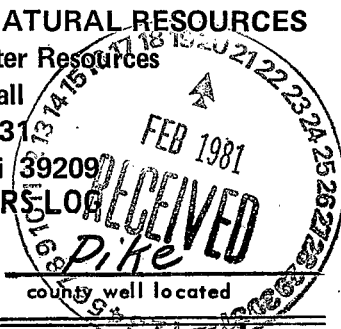

PIKE  
A 175  
2/1/81  
2-1-81  
date well completed

firm name

county well located

LANDOWNER:

Shell Oil Company  
P.O. Box 61555  
New Orleans, La 70160  
(mailing address)

description of formations encountered

from

to

gravel

0 150

WELL LOCATION: 990'S + 2340'E

sq. 18 T 40 S R 7 E of  
No. 1 West of Summit  
A.T. 1400  
(distance) (direction) (nearest town)

WELL PURPOSE: oil field supply  
(home, irrigation, municipal, industrial)

WELL COMPLETION DATA:

- (1) diameter (inches) 6"
- (2) total depth (feet) 150'
- (3) static water level (feet) 25' below top of ground.
- (4) casing Skel. 140' (material) (depth)
- 6" (size) if telescope see back.
- (5) screen 30" 110' (length) (depth to top)
- 6" stainless steel screen (size) (material)
- (6) pump 10 150 (HP) (yield gpm)
- 460 volt (type power)
- (7) electric log (yes or no)

(organization running log)

(8) how well bottom plugged 6" wood plug - back wash valve  
DRILLERS REMARKS:

DEPT. OF NATURAL RESOURCES  
BUREAU OF LAND & WATER RESOURCES


FEB 20 1981

RECEIVED



If well telescopes please sketch and show depths.

GROUND LEVEL

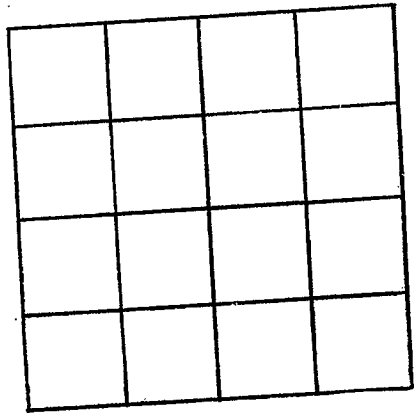

SECTION \_\_\_\_\_

Please indicate well location X.

ADDITIONAL INFORMATION

A series of horizontal lines for entering additional information.

If more than one screen, show locations of each on sketch.