

MISSISSIPPI DEPARTMENT OF NATURAL RESOURCES

Bureau of Land and Water Resources

Southport Mall

P.O. Box 10631

Jackson, Mississippi 39209

CODED

WATER WELL DRILLERS LOG

Pike
A 176
4-6-81

Griner Drilling Service, Inc.

Pike

4-6-81
date well completed

Griner Drilling Service, Inc.
firm name


Pike
county well located

LANDOWNER:	description of formations encountered	from	to
Shell Oil Company P.O. Box 61555 New Orleans, La 70160 (mailing address)	sand and gravel	0	168
	clay	168	325
	SAND	325	378
	CODED		
WELL LOCATION: 2240'S + 95'E NO. 18 T 40 S R 7 E of Turner et al unit West of Summit (distance) (direction) (nearest town)			
WELL PURPOSE: oil field supply (home, irrigation, municipal)			
WELL COMPLETION DATA:			
(1) diameter (inches) 4"			
(2) total depth (feet) 378'			
(3) static water level (feet) 150' below top of ground			
(4) casing steel 378' (material) (depth) 4" (size) If telescope see back.			
(5) screen 42' 336' (length) (depth to top) 4" perforated (size) (material)			
(6) pump 60 (HP) (yield gpm) AC (type power)			
(7) electric log _____ (yes or no) (organization running log)			
(8) how well bottom plugged peel <u>Orange</u>			
DRILLERS REMARKS:			



If well telescopes please sketch and show depths.

GROUND LEVEL

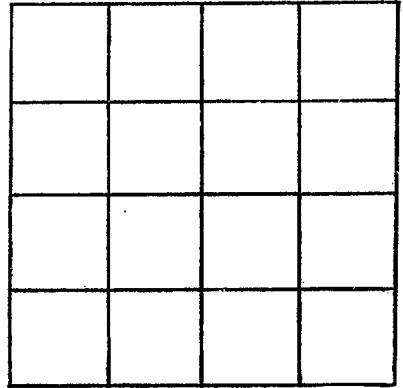

SECTION _____

Please indicate well location X.

ADDITIONAL INFORMATION

If more than one screen,
show locations of each on sketch.