

MISSISSIPPI DEPARTMENT OF NATURAL RESOURCES

Bureau of Land and Water Resources

Southport Mall

P.O. Box 10631

Jackson, Mississippi 39209

WATER WELL DRILLERS LOG

CODED

Pike  
A177  
4-6-81

4-6 8'GRINER Pike  
date well completed firm name county well located

LANDOWNER: Shell Oil Co description of formations encountered from to

Sand-gravel 0 168

(mailing address)

WELL LOCATION:

CODED

#2 well sec 18 T 4 N R 7 E S 2240' S + 1950' E of NW/4

(distance) miles (direction) of (nearest town)

WELL PURPOSE:  
(home, irrigation, municipal, industrial)

WELL COMPLETION DATA:

- (1) diameter (inches) 4"
- (2) total depth (feet) 168'
- (3) static water level (feet) 15' below top of ground.
- (4) casing steel 168' (material), (depth)
- 4" (size) if telescope see back.
- (5) screen 42' 126' (length), (depth to top)
- 4" perforated (size), (material)
- (6) pump 90 (HP), (yield gpm)
- AC (type power)
- (7) electric log (yes or no)
- (organization running log)




(8) how well bottom plugged ORANGE peel

DRILLERS REMARKS:

If well telescopes please sketch and show depths.

GROUND LEVEL

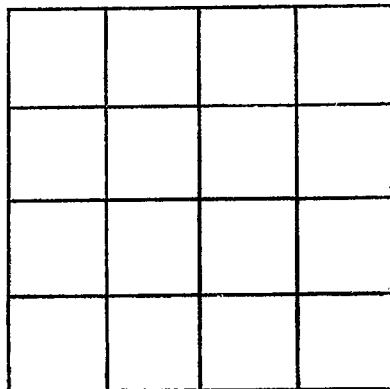

SECTION \_\_\_\_\_

Please indicate well location X.

ADDITIONAL INFORMATION

If more than one screen, show locations of each on sketch.