

MISSISSIPPI DEPARTMENT OF NATURAL RESOURCES

Bureau of Land and Water Resources

Southport Mall

P.O. Box 10631

Jackson, Mississippi 39209

WATER WELL DRILLERS LOG

CODED

<i>Pike</i>
<i>A178</i>
<i>5-4-81</i>

Griner Drilling Service, Inc.

Pike

date well completed

firm name

county well located

LANDOWNER:
Shell Oil Company
P.O. Box 61555
New Orleans, La
(mailing address) *70160*

description of formations encountered

from

to

sand + gravel 0 168

WELL LOCATION: *2200' N + 2715' E*

Zone 18 sec. *18* T. *40* S. R. *7* E. of *Sulcor*

Summitt miles of (distance) (direction) (nearest town)

CODED

WELL PURPOSE: *oil field*
(home, irrigation, municipal, industrial, *supply*)

WELL COMPLETION DATA:

- (1) diameter (inches) *4"*
- (2) total depth (feet) *168'*
- (3) static water level (feet) *20* (below/above top of ground)
- (4) casing *steel*, *147'* (material) (depth)
4" (size) if telescope see back.
- (5) screen *42'*, *105'* (length) (depth to top)
4" (size) *perforated* (material)
- (6) pump *—*, *80* (HP) (yield gpm)
AC (type power)
- (7) electric log *—* (yes or no)

(organization running log)

(8) how well bottom plugged *orange*
peel

DRILLERS REMARKS:


DEPT. OF NATURAL RESOURCES
BUREAU OF LAND & WATER RESOURCES

MAY 28 1981

RECEIVED

If well telescopes please sketch and show depths.

GROUND LEVEL

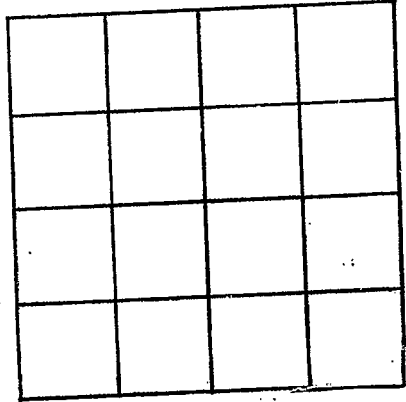

SECTION _____

Please indicate well location X.

ADDITIONAL INFORMATION

If more than one screen, show locations of each on sketch.