

MISSISSIPPI DEPARTMENT OF NATURAL RESOURCES

Bureau of Land and Water Resources

Southport Mall

P.O. Box 10631

Jackson, Mississippi 39209

WATER WELL DRILLERS LOG

**CODED**

Pike  
A 179  
7-28-81

Griner Drilling Service, Inc.

Pike

7-28-81 date well completed

Griner Drilling Service, Inc. firm name

Pike county well located

LANDOWNER:

Shell Oil Company  
P.O. Box 61555  
New Orleans, La 70160  
(mailing address)

description of formations encountered

from

to

sand, pea gravel 0 189

WELL LOCATION: 924'N & 927'E

#1 sec. 18 T. 4 N R. 7 E SW/4  
Caruth Olive Field  
(distance) mil. (direction) of (nearest town)

WELL PURPOSE: oil field supply  
(home, irrigation, municipal, industrial)

WELL COMPLETION DATA:

- (1) diameter (inches) 4"
- (2) total depth (feet) 189'
- (3) static water level (feet) 40' below top of ground.
- (4) casing steel 189' (material) (depth)  
4" (size) If telescope see back.
- (5) screen 42' 147' (length) (depth to top)  
4" perforated (size) (material)
- (6) pump — 80 (HP) (yield gpm)  
AC (type power)
- (7) electric log — (yes or no)

(organization running log)

- (8) how well bottom plugged Orange peel

DRILLERS REMARKS:

DEPT. OF NATURAL RESOURCES  
BUREAU OF LAND & WATER RESOURCES


AUG 26 1981

**RECEIVED**

AUG 1981  
**RECEIVED**  
17 18 19 20 21 22 23 24 25 26 27 28 29 30 31

If well telescopes please  
sketch and show depths.

GROUND LEVEL

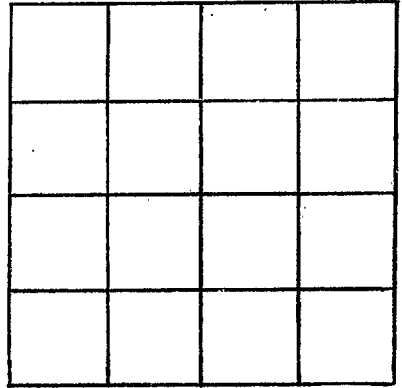

SECTION \_\_\_\_\_

Please indicate well location X.

ADDITIONAL INFORMATION

If more than one screen,  
show locations of each on sketch.