

MISSISSIPPI DEPARTMENT OF NATURAL RESOURCES

Bureau of Land and Water Resources

Southport Mall

P.O. Box 1063

Jackson, Mississippi 39209

WATER WELL DRILLERS LOG

Griner Drilling Service, Inc.

CODED and drilled on location

Pike

Pike
A 180
7-20-81

7-20-81 date well completed

Griner Drilling Service, Inc. firm name

Pike county well located

LANDOWNER:

#1 Shell Oil Company
P.O. Box 61555
New Orleans, La 70160
(mailing address)

description of formations encountered

from to

sand, pea gravel 6 168

WELL LOCATION: 2036' S + 2921' W

sec. 18 T 4^S R 7 E NE/4th COR

#2 Hoto Olive Field
(distance) (direction) (nearest town)

WELL PURPOSE: oil field (home, irrigation, municipal, industrial)

WELL COMPLETION DATA:

(1) diameter (inches) 4"

(2) total depth (feet) 108'

(3) static water level (feet) 40' below top of ground

(4) casing Steel, 108' (material) (depth)

4" (size) if telescope see back.

(5) screen 42' 126' (length) (depth to top)

4" perforated (size) (material)

(6) pump AC 80 (HP) (yield gpm)

AC (type power)

(7) electric log (yes or no)

(organization running log)

(8) how well bottom plugged

DRILLERS REMARKS:

CODED

DEPT. OF NATURAL RESOURCES
BUREAU OF LAND & WATER RESOURCES


AUG 26 1981

RECEIVED

AUG 1981
RECEIVED

If well telescopes please sketch and show depths.

GROUND LEVEL

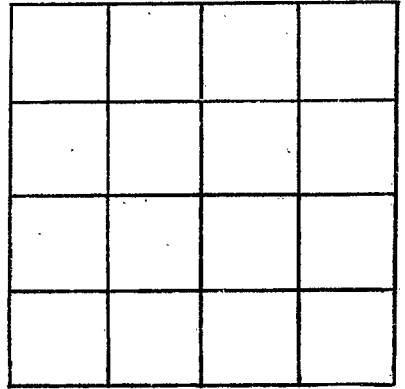

SECTION _____

Please indicate well location X.

ADDITIONAL INFORMATION

If more than one screen,
show locations of each on sketch.