

MISSISSIPPI DEPARTMENT OF NATURAL RESOURCES

Bureau of Land and Water Resources

Southport Mall

P.O. Box 10631

Jackson, Mississippi 39209

WATER WELL DRILLERS LOG

CODED

PIKE
A 184
11/10/81

11-10-81 Griner Drilling Service, Inc.

Pike

date well completed

firm name

county well located

LANDOWNER:

Shell Oil Company
P.O. Box 61555
New Orleans, La 70160
(mailing address)

description of formations encountered

from

to

Gravel-sand

0 189

WELL LOCATION:

1650' N + 990' W

sec 18 T 4 N R 7 E SE 1/4

No. 1 Frasier Olive Field
(distance) (direction) (nearest town)

WELL PURPOSE: oil field supply
(home, irrigation, municipal, industrial)

WELL COMPLETION DATA:

(1) diameter (inches) 4"
(2) total depth (feet) 189'

(3) static water level (feet) 30' below top of ground.

(4) casing steel 189'
(material) (depth)
4" (size) if telescope see back.

(5) screen 40' 147'
(length) (depth to top)
4" perforated
(size) (material)

(6) pump 80
(HP) (yield gpm)
AC
(type power)

(7) electric log
(yes or no)
(organization running log)

(8) how well bottom plugged Orange
peel


DRILLERS REMARKS:

CODED

DEPT. OF NATURAL RESOURCES
BUREAU OF LAND & WATER RESOURCES
DEC - 9 1981
RECEIVED

If well telescopes please
sketch and show depths.

GROUND LEVEL

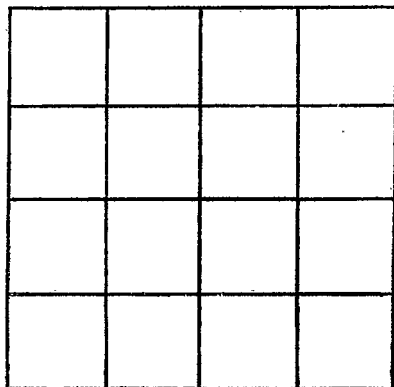

SECTION _____

Please indicate well location X.

ADDITIONAL INFORMATION

If more than one screen,
show locations of each on sketch.