

MISSISSIPPI DEPARTMENT OF NATURAL RESOURCES

Bureau of Land and Water Resources

Southport Mall

P.O. Box 10631

Jackson, Mississippi 39209

WATER WELL DRILLERS LOG

Griner Drilling Service, Inc.

CODED
Pike

PIKE
A 186
12-14-81

12-14-81
date well completed

Griner Drilling Service, Inc.
firm name

Pike
county well located

LANDOWNER:	description of formations encountered	from	to
Shell Oil Company P.O. Box 61555 New Orleans 70165 (mailing address)	sand, peagavel chalk	0	168 168 187
WELL LOCATION: 660' N + 660' E sec. 7 T 40 R 7 E of No. 2 Olive Field Tulsa miles (direction) of (nearest town)			
WELL PURPOSE: oil field supply (home, irrigation, municipal, industrial)			
WELL COMPLETION DATA:			
(1) diameter (inches) 4"			
(2) total depth (feet) 189'			
(3) static water level (feet) 40' below top of ground.			
(4) casing steel, 168' (material), (depth), 4" (size) if telescope see back.			
(5) screen 42' (length), 126' (depth to top), 4" perforated (size), (material)			
(6) pump - (HP), 75 (yield gpm), AC (type power)			
(7) electric log (yes or no)			
(organization running log)			
(8) how well bottom plugged peel Orange			
DRILLERS REMARKS:			

CODED


DEPT. OF NATURAL RESOURCES
BUREAU OF LAND & WATER RESOURCES

JAN 21 1982

RECEIVED

If well telescopes please
sketch and show depths.

GROUND LEVEL

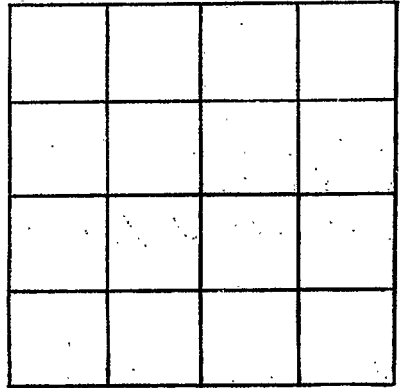

RECEIVED

SECTION _____

Please indicate well location X.

82 JAN 21 A 8: 42

ADDITIONAL INFORMATION

If more than one screen,
show locations of each on sketch.