

MISSISSIPPI DEPARTMENT OF NATURAL RESOURCES

Bureau of Land and Water Resources

Southport Mall

P.O. Box 10631

CODED

Jackson, Mississippi 39209

WATER WELL DRILLERS LOG

Griner Drilling Service, Inc.

Pike

PIKE
A 187
2/2/82

2-2-82 date well completed

Griner Drilling Service, Inc. firm name

Pike county well located

LANDOWNER:

Shell Oil Company
P.O. Box 61555
New Orleans, La 70160
(mailing address)

description of formations encountered

from

to

SAND

0 50

clay

50 60

SAND

60 150

clay

150 161

clay

161 189

WELL LOCATION:

660'S + 2130'E

No. sec. 19 T. 40N

R. 7E NW/4

Paterson Olive Field
(distance) (direction) (nearest town)

WELL PURPOSE: oil field supply
(home, irrigation, municipal, industrial)

WELL COMPLETION DATA:

- (1) diameter (inches) 4"
- (2) total depth (feet) 189'
- (3) static water level (feet) 40' below top of ground.

CODED

- (4) casing steel, 147' (material) (depth)
4" (size) if telescope see back.

- (5) screen 42' (length) 105' (depth to top)
4" perforated (size) (material)

- (6) pump AC (HP) 75 (yield gpm)
(type power)

- (7) electric log (yes or no)
- (organization running log)

- (8) how well bottom plugged orange
peel

DRILLERS REMARKS:


DEPT. OF NATURAL RESOURCES
BUREAU OF LAND & WATER RESOURCES

FEB 16 1982

RECEIVED

If well telescopes please
sketch and show depths.

GROUND LEVEL

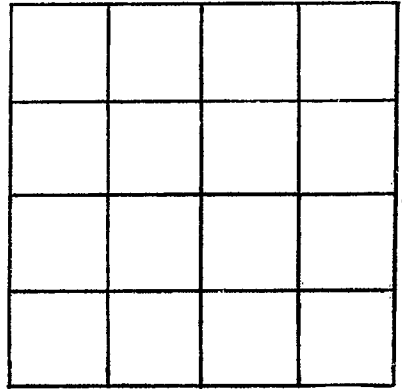

SECTION _____

Please indicate well location X.

ADDITIONAL INFORMATION

If more than one screen,
show locations of each on sketch.