

Pike
A189
5-30-82

MISSISSIPPI
BOARD OF WATER COMMISSIONERS
416 North State Street
Jackson, Mississippi 39201

INDEXED

WATER WELL DRILLERS LOG

— 5/30 19 82 — TOM GRIFFITH — Pike
date well completed county well located

DRILLER'S NAME: TOM GRIFFITH
DRILLER'S ADDRESS: 821 WAYSON AVE
COLUMBIA, MS 39202

LANDOWNER:	description of formations encountered	from	to
Shell Oil Co.	Sand & Pea Gravel	0	80
(mailing address)	Chalk	80	100
WELL LOCATION:	Sand & Pea Gravel	100	165
sec. 18 T 4 N R 7 E S W			
10 miles NW of McComb			
(distance) (direction) (nearest town)			
WELL PURPOSE: Oil Well			
(home, irrigation, municipal, industrial)			
WELL COMPLETION DATA:			
(1) diameter (inches) 4"			
(2) total depth (feet) 165'			
(3) static water level (feet) 60' below top of ground.			
(4) casing steel 125' (material) (depth)			
4" (size) if telescope see back.			
(5) screen 40' 125' (length) (depth to top)			
4" (size) Steel Slot (material)			
(6) pump 75 (HP) (yield gpm)			
Oil (type power)			
(7) electric log no (yes or no)			
7/1/82 (organization running log)			
(8) how well bottom plugged Wellbed			
DRILLERS REMARKS:			

INDEXED


DEPT. OF NATURAL RESOURCES
BUREAU OF LAND & WATER RESOURCES

JUN - 9 1982

RECEIVED

If well telescopes please sketch and show depths.

GROUND LEVEL

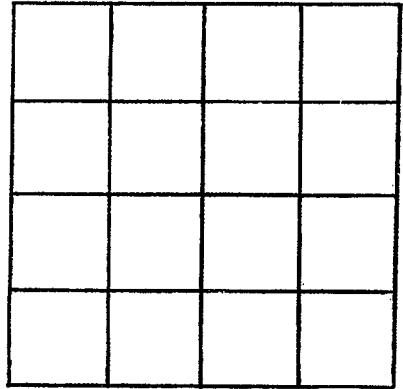

SECTION _____

Please indicate well location X.

ADDITIONAL INFORMATION

If more than one screen,
show locations of each on sketch.