

MISSISSIPPI DEPARTMENT OF NATURAL RESOURCES

Bureau of Land and Water Resources

Southport Mall

P.O. Box 10631

Jackson, Mississippi 39209

WATER WELL DRILLERS LOG

Griner Drilling Service, Inc.

Pike

Pike
A192
6-30-82

307 D

6-30-82

date well completed

firm name

county well located

LANDOWNER:	description of formations encountered	from	to
Shell Oil Company P.O. Box 61555 New Orleans, La 70162 (mailing address)	chalk, sand	0	21
WELL LOCATION: 637' S + 651' W sec. 19 T-4 N R-7 E 10 W Cotton Olive Field et al No. 1 Unit (distance) (direction) (nearest town)	sand, pea gravel	21	189
WELL PURPOSE: oil field, supply (home, irrigation, municipal, industrial)	chalk	189	231
WELL COMPLETION DATA:	Elevation: 440 Feet		
(1) diameter (inches) 4"	090322331172602		
(2) total depth (feet) 231'			
(3) static water level (feet) 30' below top of ground.			
(4) casing steel 189' (material), (depth) 4" (size) if telescope see back.			
(5) screen 42' 147' (length), (depth to top) 4" perforated (size), (material)			
(6) pump AC (HP), 75 (yield gpm) (type power)			
(7) electric log (yes or no)			
(8) how well bottom plugged orange peel (organization running log)			

DEPT. OF NATURAL RESOURCES
BUREAU OF LAND & WATER RESOURCES


DRILLERS REMARKS:

JUL 16 1982

RECEIVED

If well telescopes please sketch and show depths.

GROUND LEVEL

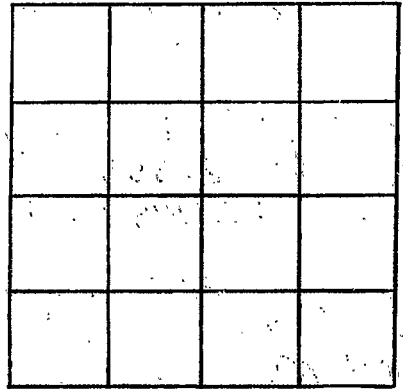

SECTION _____

Please indicate well location X.

ADDITIONAL INFORMATION

If more than one screen, show locations of each on sketch.