

MISSISSIPPI DEPARTMENT OF NATURAL RESOURCES

Bureau of Land and Water Resources

Southport Mall

P.O. Box 10631

Jackson, Mississippi 39209

WATER WELL DRILLERS LOG

Griner Drilling Service, Inc.

Pike

PIKE  
A 193  
7-21-82

RECEIVED

7-21-82 date well completed

Griner Drilling Service, Inc. firm name

Pike county well located

LANDOWNER:  
Shell Oil Company  
P.O. Box 61555  
New Orleans, La. 70160  
(mailing address)

description of formations encountered	from	to
sand, pea gravel	0	168

WELL LOCATION: 310'S 1995'E  
sec. 19 T. 4N R. 7E cor  
No. 2 Carruth Olive Field  
G.S. (distance) (direction) (nearest town)  
et al

WELL PURPOSE: oil field supply  
(home, irrigation, municipal, industrial)

RECEIVED

WELL COMPLETION DATA:

- (1) diameter (inches) 4"
- (2) total depth (feet) 168'
- (3) static water level (feet) 20' below top of ground.
- (4) casing Steel 168' (material) (depth)  
4" (size) if telescope see back.
- (5) screen 42' 126' (length) (depth to top)  
4" perforated (size) (material)
- (6) pump — 80 (HP) (yield gpm)  
AC (type power)
- (7) electric log — (yes or no)

(organization running log)

(8) how well bottom plugged orange peel

DRILLERS REMARKS:


DEPT. OF NATURAL RESOURCES  
BUREAU OF LAND & WATER RESOURCES

JUL 27 1982

RECEIVED

If well telescopes please  
sketch and show depths.

GROUND LEVEL

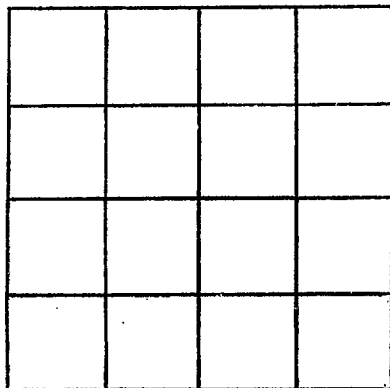

SECTION \_\_\_\_\_

Please indicate well location X.

ADDITIONAL INFORMATION

If more than one screen,  
show locations of each on sketch.