

MISSISSIPPI DEPARTMENT OF NATURAL RESOURCES

Bureau of Land and Water Resources

Southport Mall

P.O. Box 10631

Jackson, Mississippi 39209

WATER WELL DRILLERS LOG

File #  
A194  
1/17/82

11-17-82 19 Don Griffith Well Pike  
 date well completed firm name county well located

LANDOWNER:  
Shell Oil Co Bof 20193  
Biggs St 1  
Need Wilson's Dr  
 (mailing address)

description of formations encountered	from	to
<u>Clay</u>	<u>0</u>	<u>18</u>
<u>Sand &amp; Gravel</u>	<u>18</u>	<u>170</u>
<u>Chalk</u>	<u>170</u>	<u>140</u>
<u>Pea Gravel</u>	<u>140</u>	<u>210</u>

WELL LOCATION:  
 sec. 19 T4 N R. 7 E  
10 miles W of M.C. Comb  
 (distance) (direction) (nearest town)

1700'S & 1002' W of  
NE/CO

WELL PURPOSE:  
Supply (home, irrigation, municipal, industrial)

WELL COMPLETION DATA:

(1) diameter (inches) 4"

(2) total depth (feet) 210'

(3) static water level (feet) 40' below above top of ground.

(4) casing Steel 40  
 (material) (depth)

N/A If telescope see back.  
 (size)

(5) screen 40 170  
 (length) (depth to top)

4" steel slots  
 (size) (material)

(6) pump None 85  
 (HP) (yield gpm)

Electric air lift  
 (type power)

(7) electric log None  
 (yes or no)

N/A  
 (organization running log)

(8) how well bottom plugged welded  
Plugged

CODED

DEPT. OF NATURAL RESOURCES  
 BUREAU OF LAND & WATER RESOURCES


JAN 28 1982

RECEIVED

DRILLERS REMARKS:

If well telescopes please sketch and show depths.

GROUND LEVEL

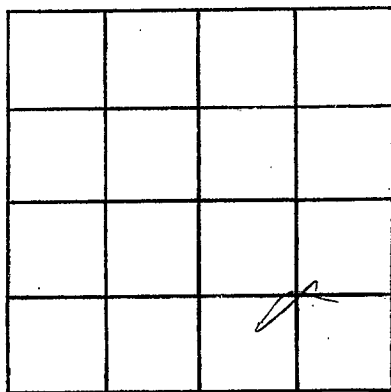

SECTION 19

Please indicate well location X.

ADDITIONAL INFORMATION

If more than one screen,  
show locations of each on sketch.