

**MISSISSIPPI DEPARTMENT OF NATURAL RESOURCES**  
**Bureau of Land and Water Resources**  
 Southport Mall  
 P.O. Box 10631  
 Jackson, Mississippi 39209

**WATER WELL DRILLERS LOG**

PIKE  
A 195  
11/18/82

11/18/82  
 date well completed

Tom Duffin Well Service  
 firm name

Pike  
 county well located

**LANDOWNER:** Shell Oil Co.  
Patterson #6 Pro. Bldg 93  
New Orleans 70160  
 (mailing address)

description of formations encountered	from	to
Sand	6	26
Large Gravel @ (check)	20	40
Deep gravel	40	70
	70	165

**WELL LOCATION:**  
 sec. 19 T. 4 (N) R. 7 (E)  
10 miles (distance) N.W. (direction) of McComb (nearest town)

22975 E 987 E  
of NW 1/4

**WELL PURPOSE:** OIL LOC.  
 (home, irrigation, municipal, industrial)

- WELL COMPLETION DATA:**
- (1) diameter (inches) 4 1/4
  - (2) total depth (feet) 165
  - (3) static water level (feet) 15' below above top of ground.
  - (4) casing steel 125'  
 (material) (depth)  
N/A if telescope see back.  
 (size)
  - (5) screen 40' 125'  
 (length) (depth to top)  
4" steel 5/8"  
 (size) (material)
  - (6) pump None 100  
 (HP) (yield gpm)  
Electric air lift  
 (type power)
  - (7) electric log None  
 (yes or no)  
N/A  
 (organization running log)

**CODED**

DEPT. OF NATURAL RESOURCES  
 BUREAU OF LAND & WATER RESOURCES

**JAN 28 1983**


**RECEIVED**

(8) how well bottom plugged welded  
plugged

**DRILLERS REMARKS:**

If well telescopes please  
sketch and show depths.

GROUND LEVEL

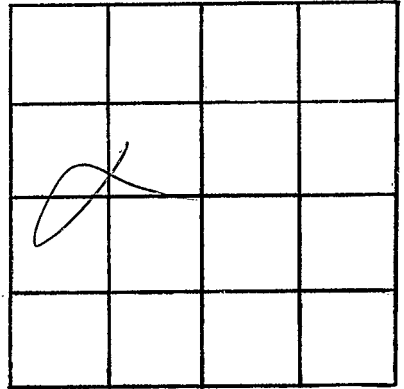

SECTION 19

Please indicate well location X.

ADDITIONAL INFORMATION

If more than one screen,  
show locations of each on sketch.