

A 98
 Pike Co.
 3-9-84

MISSISSIPPI
 BOARD OF WATER COMMISSIONERS
 416 North State Street
 Jackson, Mississippi 39201

CODED

WATER WELL DRILLERS LOG

TOM GRIFFITH
 PLUMBING & WELL SERVICE, INC.

Pike

3-9-84
 date well completed

640 MAYSON AVE.
 COLUMBIA, MS 39429

county well located

LANDOWNER: DAVID NEW DRILLING CO. PO Box 1487 Natchez, Ms 39120 (mailing address)	description of formations encountered	from	to
WELL LOCATION: sec. 2 T 40 N R 70 E 5 miles N of Summit (distance) (direction) (nearest town)	fill dirt sand clay Poa gravel CODED.	0' 5' 45' 65'	5' 45' 65' 200'
WELL PURPOSE: SUPPLY (home, irrigation, municipal, industrial)	Futrex Petroleum Inc.		
WELL COMPLETION DATA: (1) diameter (inches) 3" (2) total depth (feet) 150' (3) static water level (feet) 35' below top of ground. (4) casing Steel 110' (material) (depth) N/A if telescope see back. (5) screen 40' 150' 110' (length) (depth to top) 3" Slotted Steel (size) (material) (6) pump 65 (HP) (yield gpm) diesel (type power) (7) electric log N/A (yes or no) N/A (organization running log) (8) how well bottom plugged welded	No. 1 Smith 2-9 2255' N + 916' W of SE/4th Sec 2-4N-7E		
DRILLERS REMARKS:			


DEPT. OF NATURAL RESOURCES
 BUREAU OF LAND & WATER RESOURCES

APR 19 1984

RECEIVED

If well telescopes please sketch and show depths.

GROUND LEVEL

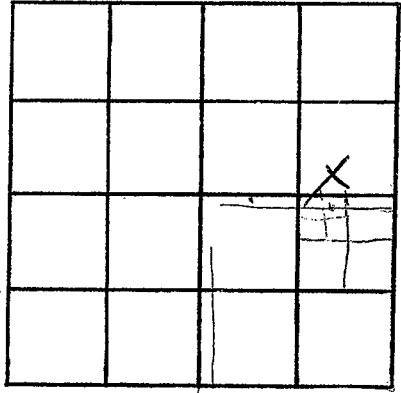

SECTION 2

Please indicate well location X.

ADDITIONAL INFORMATION

If more than one screen,
show locations of each on sketch.