

MISSISSIPPI DEPARTMENT OF NATURAL RESOURCES

Bureau of Land and Water Resources

Southport Mall

P.O. Box 10631

Jackson, Mississippi 39209

WATER WELL DRILLERS LOG

CODED

A 199
PIKE
11-24-84

11-24-84

Griner Drilling Service, INC.

Pike

date well completed

firm name

county well located

LANDOWNER:
See Land Drilling Co.
900 Dunn Street
Houma, La. 70360
(mailing address)

description of formations encountered

from to

chalk

0 10

sand, gravel

10 190

WELL LOCATION: 330' S + 330' E
sec. 7 T. 40N R. 7E of
No. 1 Anders East Fork
miles (distance) of (direction) (nearest town)

WELL PURPOSE: oilfield supply
(home, irrigation, municipal, industrial)

CODED

WELL COMPLETION DATA:

- (1) diameter (inches) 3"
- (2) total depth (feet) 190'
- (3) static water level (feet) 30' below top of ground.
- (4) casing steel 189' (material) (depth)
3" (size) if telescope see back.
- (5) screen 42' 147' (length) (depth to top)
3" perforated (size) (material)
- (6) pump - 100 (HP) (yield gpm)
AC (type power)
- (7) electric log (yes or no)

(organization running log)

(8) how well bottom plugged Orange peel

DRILLERS REMARKS:


DEPT. OF NATURAL RESOURCES
BUREAU OF LAND & WATER RESOURCES

DEC 19 1984

RECEIVED

If well telescopes please
sketch and show depths.

GROUND LEVEL

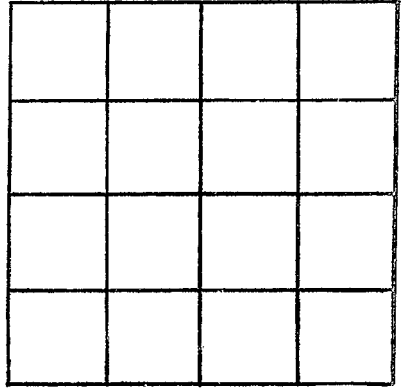

SECTION _____

Please indicate well location X.

ADDITIONAL INFORMATION

If more than one screen,
show locations of each on sketch.