

MISSISSIPPI DEPARTMENT OF NATURAL RESOURCES
 Bureau of Land and Water Resources
 Southport Mall
 P.O. Box 10631
 Jackson, Mississippi 39209
WATER WELL DRILLERS LOG

PIKE
A.201
4-25-85

4-25 1985 Fitzgerald well serv Pike
 date well completed firm name county well located

LANDOWNER:	description of formations encountered	from	to
<u>Wesley East</u>			
<u>P.O. Summit ms.</u> (mailing address)	<u>Red clay</u>	<u>0</u>	<u>10</u>
	<u>White blue chalk</u>	<u>10</u>	<u>85</u>
	<u>Coarse sand & gravel</u>	<u>85</u>	<u>102</u>
WELL LOCATION:			
sec. <u>11</u> T <u>4</u> (N) S R <u>7</u> (E) W			
<u>3</u> miles <u>H</u> of <u>Summit</u> (distance) (direction) (nearest town)			
WELL PURPOSE: <u>Home</u> (home, irrigation, municipal, industrial)			
WELL COMPLETION DATA:			
(1) diameter (inches) <u>4</u>			
(2) total depth (feet) <u>102</u>			
(3) static water level (feet) <u>3</u> below above top of ground.			
(4) casing <u>PVC</u> , <u>92</u> , (material) (depth)			
<u>4</u> if telescope see back. (size)			
(5) screen <u>10</u> , <u>92</u> (length) (depth to top)			
<u>4</u> , <u>PVC</u> (size) (material)			
(6) pump <u>1/2</u> , <u>10</u> (HP) (yield gpm)			
<u>Elva</u> (type power)			
(7) electric log <u>no</u> (yes or no)			
(8) how well bottom plugged <u>shut off</u>			


RECEIVED
 MAY 17 1985

DRILLERS REMARKS:

Department of Natural Resources
 Bureau of Land & Water Resources

If well telescopes please sketch and show depths.

GROUND LEVEL

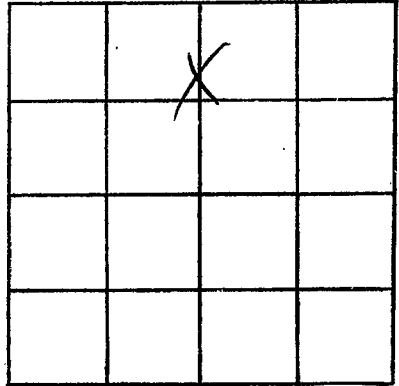

SECTION 11

Please indicate well location X.

ADDITIONAL INFORMATION

If more than one screen,
show locations of each on sketch.