

MISSISSIPPI DEPARTMENT OF NATURAL RESOURCES

Bureau of Land and Water Resources

Southport Mall

P.O. Box 10631

Jackson, Mississippi 39209

WATER WELL DRILLERS LOG

PIKE
A 203

CODED.

Griner Drilling Service, Inc.

Pike

11-2-85 date well completed

Griner Drilling Service, Inc. firm name

Pike county well located

LANDOWNER:	description of formations encountered	from	to
See Land Drilling 900 Dunn Street HOUMA, LA. 70360 (mailing address)		SAND, GRAVEL CLAY	0
WELL LOCATION: 939' S + 205' W of sec. 15 T 4 N R 7 E of No. 1 Lambert Summitt NECON DAG (distance) miles (direction) (nearest town)			
WELL PURPOSE: oilfield supply (home, irrigation, municipal, industrial)			
WELL COMPLETION DATA:			
(1) diameter (inches) 3"			
(2) total depth (feet) 168'			
(3) static water level (feet) 60' (below) above top of ground.			
(4) casing steel, 147' (material) (depth) 3" (size) if telescope see back.			
(5) screen 42' 105' (length) (depth to top) 3" perforated (size) (material)			
(6) pump - 70-75 (HP) (yield gpm) AC (type power)			
(7) electric log (yes or no) <input checked="" type="checkbox"/> no (organization running log)			
(8) how well bottom plugged ORANGE peel			


DRILLERS REMARKS:

RECEIVED
DEC 2 0 1985

Department of Natural Resources
Bureau of Land & Water Resources

If well telescopes please sketch and show depths.

GROUND LEVEL

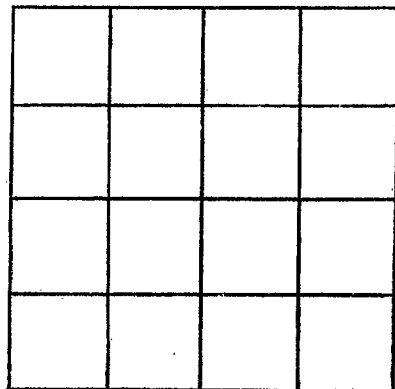

SECTION _____

Please indicate well location X.

ADDITIONAL INFORMATION

If more than one screen,
show locations of each on sketch.